

MISSISSIPPI DEPARTMENT OF NATURAL RESOURCES
Bureau of Land and Water Resources

Southport Mall
P.O. Box 10631

Jackson, Mississippi 39209

WATER WELL DRILLERS LOG

CODED

TALLAHATCHIE
A 30
5- -86

107363

5 19 86 Powell Drayton Tallahatchie
date well completed firm name county well located

LANDOWNER:
Charlie McEhter
Oakland road
(mailing address)

description of formations encountered	from	to
top Soil & clay	0	13
Fine Brown Sand	13	33
Coarse Sand & Gravel	33	95

WELL LOCATION:
sec. 20 T. 26 N. R. 2 E
10 miles South of Batesville
(distance) (direction) (nearest town)

CODED

WELL PURPOSE: FFW
(home, irrigation, municipal, industrial)

WELL COMPLETION DATA:

(1) diameter (inches) 16

(2) total depth (feet) 95

(3) static water level (feet) 8 below above top of ground.


(4) casing Steel 55
(material) (depth)
(size) if telescope see back.

(5) screen 40 55
(length) (depth to top)
16 Steel
(size) (material)

(6) pump 60 3000
(HP) (yield gpm)
Diesel
(type power)

(7) electric log no
(yes or no)
(organization running log)

(8) how well bottom plugged Steel
GATE

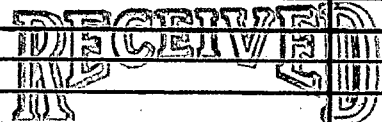


JUN 12 1986

Department of Natural Resources
Bureau of Land & Water Resources

DRILLERS REMARKS:
86108DFW-02

If well telescopes please
sketch and show depths.

GROUND LEVEL

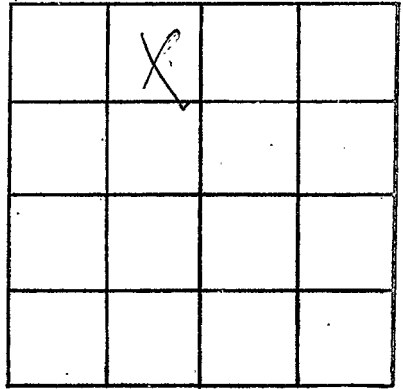

SECTION _____

Please indicate well location X.

ADDITIONAL INFORMATION

If more than one screen,
show locations of each on sketch.