

MISSISSIPPI DEPARTMENT OF NATURAL RESOURCES

Bureau of Land and Water Resources

Southport Mall

P.O. Box 10631

Jackson, Mississippi 39209

WATER WELL DRILLERS LOG

CODED

TALLAHATCHIE
A31
5-86

5 1986 date well completed

Powell Irrigation firm name

Tallahatchie county well located

LANDOWNER:	description of formations encountered	from	to
Charlie Mcatee	top soil & clay	0	13
Oakland ms	Fine Brown Sand	13	33
(mailing address)	Coarse Sand & gravel	33	95
WELL LOCATION:			
sec. 20 T. 26 N R. 2 E			
10 miles South of Batesville			
(distance) (direction) (nearest town)			
WELL PURPOSE: 2100			
(home, irrigation, municipal, industrial)			
WELL COMPLETION DATA:			
(1) diameter (inches) 16			
(2) total depth (feet) 95			
(3) static water level (feet) 8 below top of ground.			
(4) casing Steel 55 (material) (depth)			
(size) if telescope see back.			
(5) screen 40 55 (length) (depth to top)			
16 steel (size) (material)			
(6) pump 60 1200 (HP) (yield gpm)			
Diesel (type power)			
(7) electric log No (yes or no)			
(organization running log)			
(8) how well bottom plugged Steel			
Drills			
DRILLERS REMARKS: 8108 Del - 03			

CODED


RECEIVED

JUN 12 1986

Department of Natural Resources
Bureau of Land & Water Resources

If well telescopes please
sketch and show depths.

GROUND LEVEL

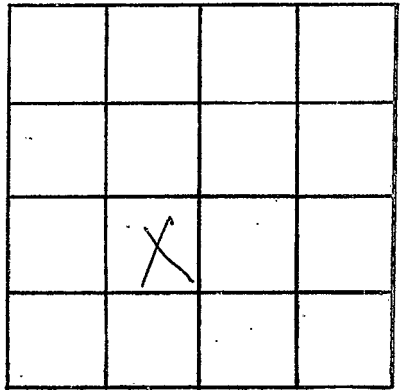

SECTION _____

Please indicate well location X.

ADDITIONAL INFORMATION

If more than one screen,
show locations of each on sketch.