

MISSISSIPPI DEPARTMENT OF NATURAL RESOURCES

Bureau of Land and Water Resources

Southport Mall

P.O. Box 10631

Jackson, Mississippi 39209

WATER WELL DRILLERS LOG

CODED

TALLAHATCHIE
A 32
5- -86

5-19-86 Powell Irrigation Tallahatchie

date well completed

firm name

county well located

LANDOWNER:
Charlie McEiter
Oakland MS
(mailing address)

description of formations encountered

from to

Top Soil + Clay	0	13
Fine Brown Sand	13	33
Coarse Sand	33	95
F. Blue		

WELL LOCATION:
sec. 20 T. 26 N R. 2 E
10 miles South of Batesville
(distance) (direction) (nearest town)

CODED

WELL PURPOSE: driv
(home, irrigation, municipal, industrial)

WELL COMPLETION DATA:

- (1) diameter (inches) 16
- (2) total depth (feet) 95
- (3) static water level (feet) 8 below above top of ground.
- (4) casing Steel 55
(material) (depth)

(size) if telescope see back.

- (5) screen 40 55
(length) (depth to top)
- 16 Steel
(size) (material)
- (6) pump 60 1200
(HP) (yield gpm)

Diesel
(type power)

- (7) electric log No
(yes or no)

(organization running log)

- (8) how well bottom plugged Steel
SLATE

RECEIVED

JUN 12 1986


Department of Natural Resources
Bureau of Land & Water Resources

DRILLERS REMARKS:

8108 DEL-04

If well telescopes please
sketch and show depths.

GROUND LEVEL

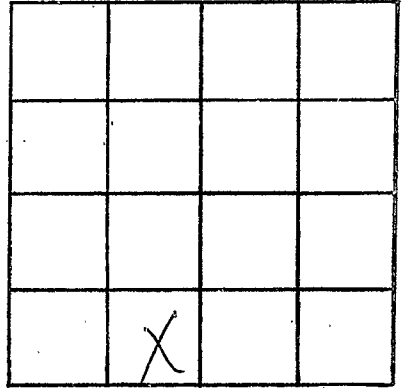

SECTION _____

Please indicate well location X.

ADDITIONAL INFORMATION

If more than one screen,
show locations of each on sketch.