County:	Tallahatchie
Permit #: Irri C	<u>Gw 40695</u> gation Equipment
Date drilli	ng completed: 11-17-05

State Well Report

Part 1

Mississippi Department of Environmental Quality
Office of Land and Water Resources
P.O. Box 10631
Jackson, MS 39289-0631
(601)961-5210
(601)354-6938 (fax)

For Office Use Only:				
Aquifer:				
Well #: A -	<u> 39 _</u>			
L. S. Elevation:				
E-log #:				


State Law requires that this report be prepared by the driller in detail and filed with the Department within 30 days of completion of drilling of the well.

30 days of completion of drilling of the well.	-
Well Owner Information	Well Location
Owner NameRusty Calvert	Latitude: 34 . 06 , 78N Longitude: 90 .08 .14W ,,
Mailing Address: Box 279	Method of Lat/Long (circle one): Conventional Survey,
	USGS quad, Hand-held GPS, Survey-grade GPS
Crowder, MS 38622	NW 14 NW 14 Sec 19 Twn 26N Rng 2E
City State Zip Code 662-326-8134 Telephone No. ()	Distance Direction Nearest Town 4 Miles South of Crowder
Well	Data
Purpose of Well (circle one) Home Industrial Public Supply	rigation Fish Culture Other:
Date well drilling started: 11-17-05 Date v	well drilling completed: 1 - 1 / - 0 5
If flowing, method of flow regulation: Valve Other (c	.
Static Water Level: 10' feet above or below (circle one)	land surface Date measured: 11-18-05
Method of Measurement (circle one) steel take electric tape	air line other:
Hole depth: 116 Well depth: 116	Well grouted to a depth of 10 feet
Type of grout (circle one): Cement Bentonite Mix	
Casing length: 76 feet Casing diameter: 10	inches Type of casing: PVC 160
Screen length: 40 feet Screen diameter: 10	inches Type of screen: <u>PVC</u> 160
Screen slot size: . 050 inches Setting depth: From	77feet to116feet
Type of completion (circle all applicable): Gravel packed Under	rreamed Telescoped Open hole Natural Development
Other (describe):	
Top of lap pipe or reduction in casing: feet. If to	elescoped or more than one screen, describe on back of page
Logs run (circle all applicable) No log run Electric Gamma Ray	Density Sonic Neutron Other:
Name of organization running log(s):	
I certify that the well was drilled, constructed, and completed in	
Department of Environmental Quality and/or the Mississippi De	partment of Health regulations and state laws.
Irrigation Equipment Inc. Patrick M. Chism 0695	Patried M Chin
Print Name of Water Well Contractor and License No.	Signature of Water Well Contractor

Ground Level

Description of Formations Encountered	From	To
Clay	0	15
Fine Sand	116	28
Fine Sand/gravel Med. Sand/gravel	29	38
Med. Sand/gravel	39	116
	-	-
	-	
		
	 	
	+	\vdash
	 	+
	+	-
		-
	+	-
	- 	+
	+	
		
	1	+
	+	\vdash
	+	
	+	1

If more than one screen, show location of each on sketch

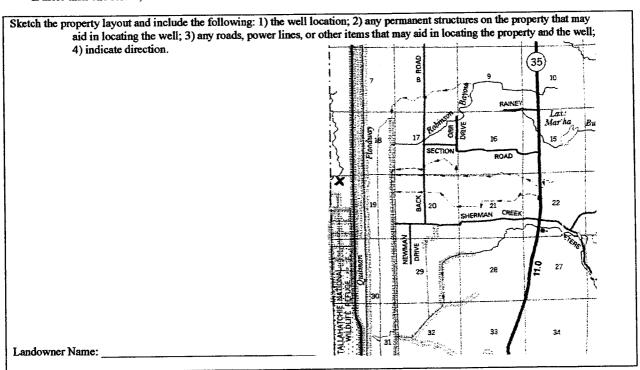

Signature of Water Well Contractor

STATE WELL REPORT

Part 2

County: Tallahatchie

Permit #:

Irrigation Equipment
Driller:

Date completed:

Tallahatchie

Pump Installer's Completion Report
Mississippi Department of Environmental Quality
Office of Land and Water Resources
P.O. Box 10631
Jackson, MS 39289-0631
(601961-5210

Print Name of Pump Installer and License No. (if applicable)

F	For Office Use Only:		
Aquifer:			
Well #:	A- 38		
Elevation	n:		

	-18-05		54-6938 (fax) Elevation:		
This report showing the control of particular terms of particular terms of the control of the co		the pump installer in de	ail and filed with the Department within 30 days of	the	
	Well Owner Inform	ation	Well Location		
Owner Name: Rus	ty Calver	t	Latitude:Longitude:		
Mailing Address:	Box 279		Method of Lat/Long (circle one): Conventional Survey,		
	Croudor	MC 29622	USGS quad, Hand-held GPS, Survey-g		
	y State 52–326–813		NW 14 NW 14 Sec 19 Twn 26N Rn Distance Direction Nearest Town 4 Miles Southof Crowder	<u>g ZE</u>	
Pump Type Circle one			Power Type Circle one		
Air Lift	Jet	Submersible	Diesel Engine Gasoline Engine N	latural Gas	
Bucket	Piston	Turbine	Electric Motor Hand To	ractor PTO	
Centrifugal	Rotary	Flowing Well	Windmill Other (specify):	· · · · · · · · · · · · · · · · · · ·	
Other (specify):			Horse Power Rating of Motor: 20	······································	
Date Pump Installed: 11-18-05			Setting Depth: 70 feet	;	
Rated Pump Capacity	: 950±	Gallons Per Minute	Number of Stages:1		
Pump Test Data		Method of Measuring Water Level Circle one			
	.):Fe	et Below Land Surface		eel Tape	
Drawdown [(B) - (A)]:Fe	et Below Land Surface	For flowing well, measured shut in head:	feet	
Test Pumping Rate: _		Gallons Per Minute	Well yieldedGPM with a drawd	iown of	
D	st (minimum 4 hour	s):hours	feet afterhours of	of pumping	

Signature of Pump Installer

RECEIVED

DEC 0 5 2005

BY: OLWR