

Job # 8436

County: Tallahatchee  
 Permit #: MS-610-48870  
 Driller: Pete's Well Drilling  
 Date drilling completed: 8-27-08

**Well Driller Report and Well Log**  
 Mississippi Department of Environmental Quality  
 Office of Land and Water Resources  
 P.O. Box 10631  
 Jackson, MS 39289-0631  
 (601)961-5210  
 (601)354-6938 (fax)

For Office Use Only:  
 Aquifer: \_\_\_\_\_  
 Well #: A-96  
 L. S. Elevation: \_\_\_\_\_  
 E-log #: \_\_\_\_\_

State Law requires that this report be prepared by the driller in detail and filed with the Department within 30 days of completion of drilling of the well.

Well Owner Information	Well Location
Owner Name: <u>S &amp; L Farm</u>	Latitude: <u>34° 08' 40.5" N</u> Longitude: <u>090° 06' 51" W</u>
Mailing Address: <u>8196 Eureka Rd</u>	Method of Lat/Long (circle one): <u>Conventional Survey</u>
<u>Cortland, MS 38628</u>	USGS quad, <u>(Hand-held GPS)</u> Survey-grade GPS
City: _____ State: _____ Zip Code: _____	<u>NW 1/4 NW 1/4 Sec 8 Twn 26N Rng 2E</u>
Telephone No. <u>(662) 561-1719</u>	Distance: <u>5</u> Miles Direction: <u>SE</u> of Nearest Town: <u>Crowder</u>

**Well Data**

Purpose of Well (circle one) Home Industrial Public Supply Irrigation Fish Culture Other: \_\_\_\_\_

Date well drilling started: 8-27-08 Date well drilling completed: 8-27-08

If flowing, method of flow regulation: Valve \_\_\_\_\_ Other (describe): \_\_\_\_\_

Static Water Level: 12 feet above or (below) (circle one) land surface Date measured: 8-27-08

Method of Measurement (circle one) steel tape electric tape air line other: \_\_\_\_\_

Hole depth: 100' Well depth: 100' Well grouted to a depth of 10 feet

Type of grout (circle one): Cement Bentonite Mix

Casing length: 60 feet Casing diameter: 16 inches Type of casing: PVC

Screen length: 40 feet Screen diameter: 16 inches Type of screen: PVC

Screen slot size: 1.032 inches Setting depth: From 60 feet to 100 feet

Type of completion (circle all applicable): Gravel packed Undercanned Telescoped Open hole Natural Development  
 Other (describe): \_\_\_\_\_

Top of lsp pipe or reduction in casing: \_\_\_\_\_ feet. If telescoped or more than one screen, describe on back of page

Logs run (circle all applicable): No log run Electric Gamma Ray Density Sonic Neutron Other: \_\_\_\_\_

Name of organization running log(s): \_\_\_\_\_

I certify that the well was drilled, constructed, and completed in accordance with all applicable requirements of the Mississippi Department of Environmental Quality and/or the Mississippi Department of Health regulations and state laws.

Pete's Well Drilling 0430 \_\_\_\_\_  
 Print Name of Water Well Contractor and License No. Signature of Water Well Contractor

If well telescopes please check below and show depths.

RECEIVED

OCT 13 2008  
 BY: OLWR

A-46

Ground Level

--


Description of Formations Encountered

From To

Description of Formations Encountered	From	To
Mud/Clay	0	15
Coarse Sand/Gravel	15	100

If more than one screen, show location of each on sketch

Sketch the property layout and include the following: 1) the well location; 2) any permanent structures on the property that may aid in locating the well; 3) any roads, power lines, or other items that may aid in locating the property and the well; 4) indicate direction.

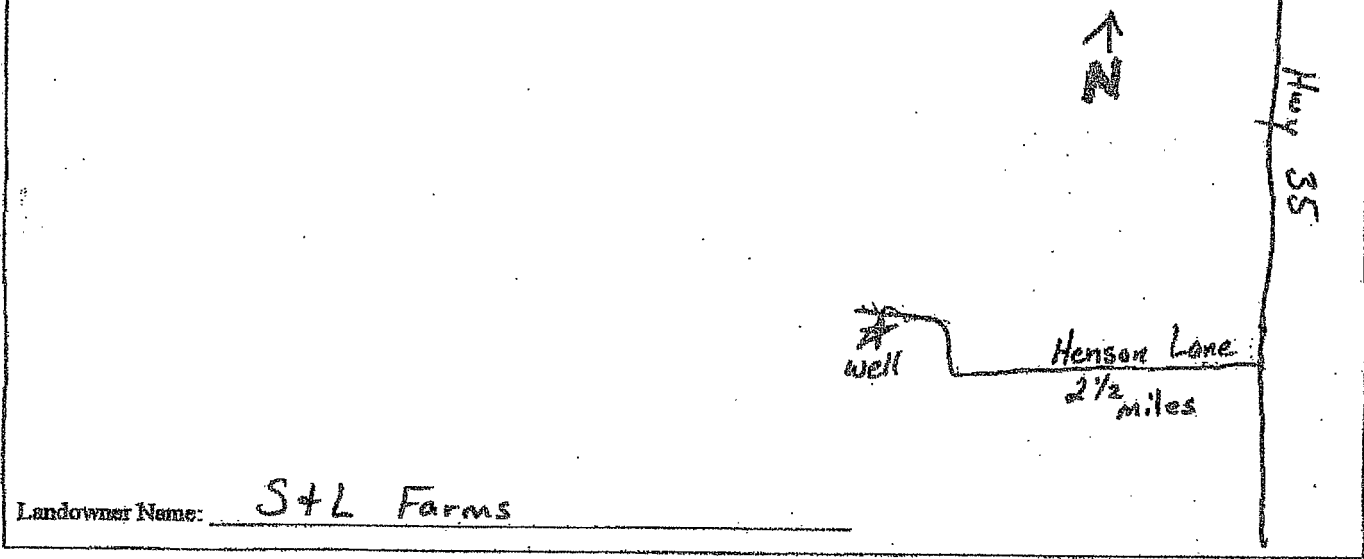

Landowner Name: S+L Farms

  
\_\_\_\_\_  
Signature of Water Well Contractor

RECEIVED  
OCT 13 2008  
BY: OLWR

034° 10' 30.00" N

034° 10' 00.00" N

034° 09' 30.00" N

034° 10' 30.00" N

034° 10' 00.00" N

034° 09' 30.00" N

CROWDER

23

Well

090° 08' 00.00" W

090° 07' 30.00" W

090° 07' 00.00" W

090° 06' 30.00" W

Datum: NAD83

Copyright (C) 2008 Mantech, Inc.

map loc. doesn't match lat/long

# STATE WELL REPORT

## Part 2

**Pump Installer's Completion Report**  
 Mississippi Department of Environmental Quality  
 Office of Land and Water Resources  
 P.O. Box 10631  
 Jackson, MS 39289-0631  
 (601)961-5210  
 (601)354-6938 (fax)

County: TALLAHATCHIE  
 Permit #: \_\_\_\_\_  
 Driller: PETES WELL DRILLING  
 Date completed: 8-27-08  
*Conv information from block on Part 1*

For Office Use Only:

Aquifer: \_\_\_\_\_  
 Well #: A-46  
 Elevation: \_\_\_\_\_

*This part of the report must be completed by a licensed water well contractor or a licensed pump installer. A copy of Part 1 of the report must be attached and both parts filed with the Department at the above address within 30 days of well completion.*

Well Owner Information	Well Location
Owner Name: <u>S &amp; L FARMS</u>	Latitude: <u>34° 9' 22"</u> Longitude: <u>090° 06' 51"</u>
Mailing Address: <u>8196 Eureka Rd</u>	Method of Lat/Long (check one): Conventional Survey _____
<u>Courtland, MS 38628</u>	USGS quad _____, Hand-held GPS _____, Survey-grade GPS _____
City State Zip Code	<u>1/4</u> _____ <u>1/4</u> Sec <u>5</u> T <u>26</u> R <u>2</u> E
Telephone No. <u>(662) 561-1719</u>	Distance Direction Nearest Town
	<u>1 1/2</u> Miles <u>SE</u> of <u>Crowder</u>

Pump Type Circle one	Power Type Circle one
Air Lift      Jet      Submersible	<u>Diesel Engine</u> Gasoline Engine      Natural Gas
Bucket      Piston <u>Turbine</u>	Electric Motor      Hand      Tractor PTO
Centrifugal      Rotary      Flowing Well	Windmill      Other (specify): _____
Other (specify): _____	Horse Power Rating of Motor: <u>80</u>
Date Pump Installed: <u>9-10-08</u>	Setting Depth: <u>60</u> feet
Rated Pump Capacity: <u>1200</u> Gallons Per Minute	Number of Stages: <u>3</u>

Pump Test Data	Method of Measuring Water Level Circle one
Date Well Tested: _____	Air Line      Electric Measuring Line <u>Steel Tape</u>
Static Water Level (A): <u>12</u> Feet Below Land Surface	Other (specify): _____
Pumping Water Level (B): _____ Feet Below Land Surface	For flowing well, measured shut in head: _____ feet
Drawdown [(B) - (A)]: _____ Feet Below Land Surface	Well yielded _____ GPM with a drawdown of _____
Test Pumping Rate: _____ Gallons Per Minute	_____ feet after _____ hours of pumping
Duration of Pump Test (minimum 4 hours): _____ hours	

I HEREBY CERTIFY that the above statements are true to the best of my knowledge.

David P. Holt 0-752P      [Signature]  
 Print Name of Pump Installer and License No. (if applicable)      Signature of Pump Installer

Form: OLWR-SWR-1B  
**RECEIVED**  
 OCT 13 2008  
 BY: OLWR

JOB  
8436