

State Well Report

Part I - Driller's Log

Mississippi Department of Environmental Quality
Office of Land and Water Resources
P.O. Box 2309
Jackson, MS 39225
(601)961-5210
(601)961-5228 (fax)

For Office Use Only:

Aquifer:
Well #: A58
L. S. Elevation:
E-log #:

County: Tallahatchie
Permit #: MS-6W-49703
Driller: TEDDY COALS
Date drilling completed: 12-9-16

State Law requires that this report be prepared by the license holder responsible for the work and filed with the Department at the above address within 30 days of completion of drilling of the well or borehole.


Information on Well Owner (Landowner if borehole is not for a water well)
Owner Name: SARTOR MA, OLIVER
Mailing Address: 1511 DUFOSSE STREET
New Orleans LA 70115
City State Zip Code
Telephone No.
Well or Borehole Location
Latitude: 34° 9' 28" N Longitude: 90° 7' 21" W
Method of Lat/Long (circle one): Conventional Survey,
USGS quad, Hand-held GPS, Survey-grade GPS
NW 1/4 NE 1/4 Sec 06 Twn 26N Rng 02E
Distance Direction Nearest Town
Miles of

Well / Borehole Data
Date drilling started: 12-9-16 Date drilling completed: 12-9-16 Hole depth: 105 Hole diameter: 28
Location of the source of any surface water used for drilling: Nearest Well
Method of dosing and volume of Chlorine used in drilling and development:
Logs run (circle all applicable): No log run Electric Gamma Ray Density Sonic Neutron Other:
Name of organization running log(s):
Purpose of borehole (check one): Water Well Geotechnical/Geological Investigation Ground Source Heat Pump
Seismic Survey Other (describe)
If drilling is not related to water well construction, skip the remainder of this block
Purpose of Well (check one): Home Industrial Public Supply Irrigation Fish Culture Other:
If a flowing well, method of flow regulation: Valve Other (describe)
Static Water Level: 20 feet above or below (circle one) land surface Date measured: 12-9-16
Method of Measurement (circle one) steel tape electric tape air line other:
Well depth: 105 Well grouted to a depth of 10 feet Type of grout (circle one): Neat Cement Bentonite Mix
Casing length: 65 feet Casing diameter: 16 inches Type of casing: P.V.C
Screen length: 40 feet Screen diameter: 16 inches Type of screen: P.V.C
Screen slot size: .050 inches Setting depth: From 0 feet to 70 feet
Type of completion (circle all applicable): Gravel packed Underreamed Telescoped Open hole Natural Development
Other (describe):
Top of lap pipe or reduction in casing: feet. If telescoped or more than one screen, describe on next page


Form: OLWR-SWR-1A (04/08)

RECEIVED
JAN 10 2017
BY OLWR

Enid, MS 38927
Enid, MS 38927
United States

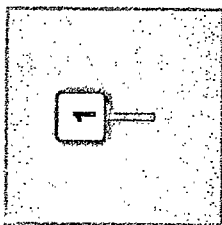

34 9 28n 90 7 21w
near Enid

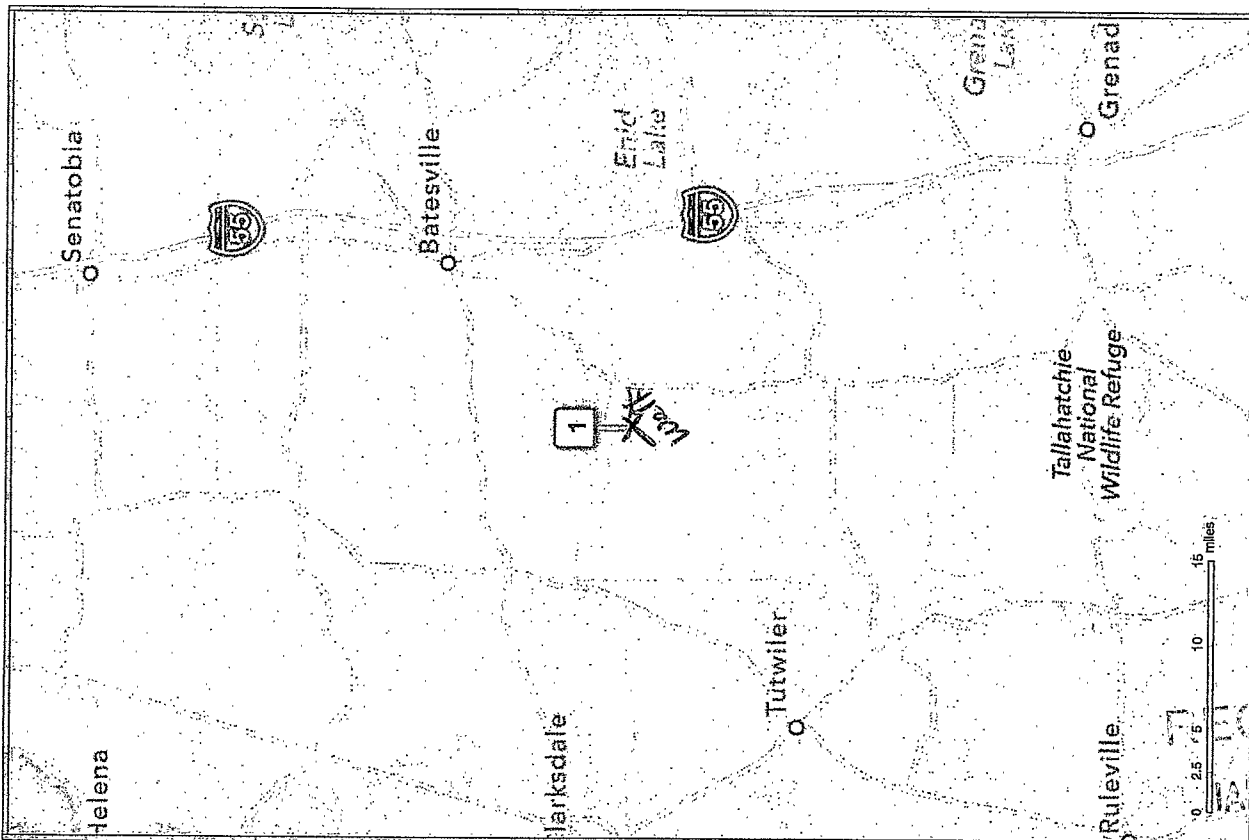

RECEIVED
JAN 10 2017
BY OLWR

STATE WELL REPORT

Part 2

Pump Installer's Completion Report
 Mississippi Department of Environmental Quality
 Office of Land and Water Resources
 P.O. Box 2309
 Jackson, MS 39225
 (601)961-5210
 (601)961-5228 (fax)

County: Tallahatchie
 Permit #: MS. LW. 49703
 Driller: TEDDY COATS
 Date completed: 12-9-16
Copy information from block on Part 1

For Office Use Only:

Aquifer: _____
 Well #: A58
 Elevation: _____

This part of the report must be completed by a licensed water well contractor or a licensed pump installer. A copy of Part 1 of the report must be attached and both parts filed with the Department at the above address within 30 days of well completion.

Well Owner Information	Well Location
Owner Name: <u>Sartor MD. Oliver</u>	Latitude: <u>34.928°N</u> Longitude: <u>90.721°W</u>
Mailing Address: <u>1511 DuFossat Street</u>	Method of Lat/Long (check one): Conventional Survey _____
<u>New orlean</u> <u>LA</u> <u>70115</u> City State Zip Code	USGS quad _____, Hand-held GPS <input checked="" type="checkbox"/> , Survey-grade GPS _____
Telephone No. () _____	NW ¼ NE ¼ Sec <u>06</u> T <u>26</u> N R <u>02E</u>
	Distance _____ Direction _____ Nearest Town _____
	_____ Miles _____ of _____

Pump Type Circle one	Power Type Circle one
Air Lift Jet Submersible	<u>Diesel Engine</u> Gasoline Engine Natural Gas
Bucket Piston <u>Turbine</u>	Electric Motor Hand Tractor PTO
Centrifugal Rotary Flowing Well	Windmill Other (specify): _____
Other (specify): _____	Horse Power Rating of Motor: <u>50 HP</u>
Date Pump Installed: <u>12-9-16</u>	Setting Depth: <u>0 70</u> feet
Rated Pump Capacity: <u>2200</u> Gallons Per Minute	Number of Stages: <u>single</u>

Pump Test Data	Method of Measuring Water Level Circle one
Date Well Tested: <u>12-9-16</u>	Air Line Electric Measuring Line <u>Steel Tape</u>
Static Water Level (A): <u>90</u> Feet Below Land Surface	Other (specify): _____
Pumping Water Level (B): <u>40</u> Feet Below Land Surface	For flowing well, measured shut in head: _____ feet
Drawdown [(B) - (A)]: <u>50</u> Feet Below Land Surface	Well yielded _____ GPM with a drawdown of _____ feet after _____ hours of pumping
Test Pumping Rate: <u>2200</u> Gallons Per Minute	
Duration of Pump Test (minimum 4 hours): <u>4</u> hours	

I HEREBY CERTIFY that the above statements are true to the best of my knowledge.

TEDDY COATS #5318
 Print Name of Pump Installer and License No. (if applicable)

Teddy Coats
 Signature of Pump Installer

RECEIVED

Form: OLWR-SWR-1B (04/08)

JAN 10 2017

BY OLWR