

TALLAHATCHIE
 A 2000
 5-30-79

MISSISSIPPI
 BOARD OF WATER COMMISSIONERS
 416 North State Street
 Jackson, Mississippi 39201

WATER WELL DRILLERS LOG

5-30 1979 North miss well Drilling Tallahatchie
 date well completed firm name county well located

LANDOWNER: AS Hudson
 (mailing address)
 WELL LOCATION:
 sec. 12 T 26 N R 2 E
 S W
 2 miles N of Treadwell
 (distance) (direction) (nearest town)

WELL PURPOSE: Home
 (home, irrigation, municipal, industrial)

WELL COMPLETION DATA:
 (1) diameter (inches) 4"
 (2) total depth (feet) 130
 (3) static water level (feet) 70 below above top of ground.
 (4) casing Plastic, 120 (material) (depth)
 (size) if telescope see back.
 (5) screen 10' 120 (length) (depth to top)
 4" Plastic (size) (material)
 (6) pump 1/2 (HP) 10 (yield gpm)
 Elec (type power)
 (7) electric log NO (yes or no)
 (organization running log)
 (8) how well bottom plugged Utah Bet

description of formations encountered	from	to
Blue Clay	0	80
Rock	80	85
Blue Clay	85	100
Sand	100	130

Miss. Board of Water Comm.


JUL 30 1979

RECEIVED

DRILLERS REMARKS:

If well telescopes please sketch and show depths.

GROUND LEVEL

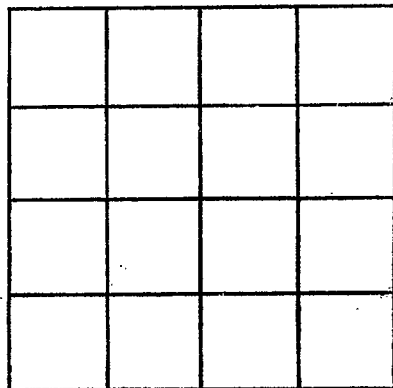

SECTION _____

Please indicate well location X.

ADDITIONAL INFORMATION

If more than one screen,
show locations of each on sketch.