

Tallahatchie
 A 2006
 7-15-76

MISSISSIPPI
 BOARD OF WATER COMMISSIONERS
 416 North State Street
 15F Jackson, Mississippi 39201

WATER WELL DRILLERS LOG

7-15 1976 Lipe well co Tallahatchie
 date well completed firm name county well located

LANDOWNER:
 Don Allison
 Charleston MS.
 (mailing address)

description of formations encountered	from	to
	Top soil	0
Gravel and sand	20	40
" " "	40	60
White sand	60	95

WELL LOCATION:
 sec. 6 T 26 N R 3 E
 S W
 8 miles north of Charleston
 (distance) (direction) (nearest town)

WELL PURPOSE:
 (home) Irrigation, municipal, industrial


- WELL COMPLETION DATA:
- (1) diameter (inches) 4
 - (2) total depth (feet) 95
 - (3) static water level (feet) 30 below top of ground.
 - (4) casing PVC 85 (material) (depth)
 4 (size) If telescope see back.
 - (5) screen 10 85 (length) (depth to top)
 4 PVC (size) (material)
 - (6) pump 3/4 10 (HP) (yield gpm)
 elec. (type power)
 - (7) electric log N/A (yes or no)
 N/A (organization running log)
 - (8) how well bottom plugged PVC CAP

DRILLERS REMARKS:

RECEIVED
 AUG 3 - 1976

If well telescopes please sketch and show depths.

GROUND LEVEL

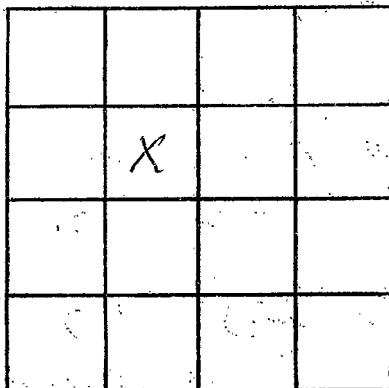

SECTION 6

Please indicate well location X.

ADDITIONAL INFORMATION

If more than one screen, show locations of each on sketch.