

TALLA.

WATER WELL DRILLERS LOG

CODED

B-2

Date: 11-29-62

19 62

Driller:

J. B. Cain
915 (Name)

County

Franklin

CODED

(1) Owner of Land:

(Name)

Richard Foulon

(Address)

Enid

(2) Location: N.W. 1/4, S.E. 1/4, Sec. 15 T26R3E

miles

(distance)

S.W. (direction)

(Nearest town)

(3) Topography:

(Hills)

(Flat)

(Level)

(4) Purpose of Well:

Home
(Domestic Irrigation, Municipal, Industrial, Other)

Description & Color of Materials
Sand, Clay, Red Clay, Shell, etc.

Thick-
ness
Feet

Depth
Feet

Bro. Clay	0	35
Sand + Str	35	90
Sand	90	110

Information upon completion of well:

(1) Diameter 2 inches.

(2) Total Depth 110 feet.

(3) Water Level 78 feet below top of ground.

(4) Cased to 110 Size 2"

(5) Screen: Size 1 1/4 Length 6 FT

(6) Were any formations sealed against pollution?


yes, no.

If YES depth of formation

Why

Drillers Remarks:

CODED

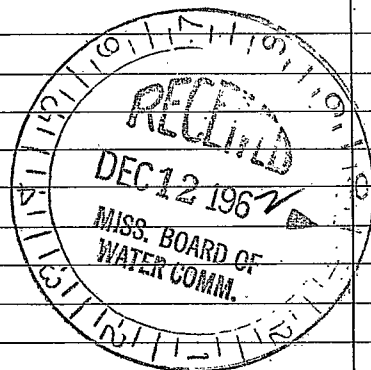

(Use Back Side)

Well No.

Retain this copy for your office files.

1911

1911

1911