

Coded

MISSISSIPPI
BOARD OF WATER COMMISSIONERS
416 North State Street
Jackson, Mississippi 39201

C14324-3689

TALLAHATCHIE
B3
3-16-73
Lot # 39

WATER WELL DRILLERS LOG

March 06, 1972 19 Singer-Layne Central Division Tallahatchie
date well completed firm name county well located

LANDOWNER: North Tallahatchie
Water Association

Charleston, Mississippi
(mailing address)

WELL LOCATION:
sec. 19 T. 26 N R. 3 E
12 miles north of Charleston
(distance) (direction) (nearest town)

WELL PURPOSE: home
(home, irrigation, municipal, industrial)

WELL COMPLETION DATA:

- (1) diameter (inches) 12 x 8
- (2) total depth (feet) 1246
- (3) static water level (feet) 185 below top of ground.
- (4) casing steel 1182' (material) (depth) 61' 3" lap 12" (size) If telescope see back.
- (5) screen 60' 3" 1239' 6" (length) (depth to top) 8" S. Steel (size) (material) 6' 6" BPV
- (6) pump 60 500 (HP) (yield gpm) electric (type power)
- (7) electric log yes (yes or no) Miss. Geological Survey (organization running log)
- (8) how well bottom plugged BPV

description of formations encountered	from	to
Clay	0	30
Gravel	30	185
Shale	185	235
Rock	235	236
Sandy shale	236	456
Sand	456	581
Sandy shale	581	625
Sand	625	651
Sandy shale	651	669
Shale	669	675
Rock	675	676
Sandy shale	676	718
Shale	718	820
Hard shale	820	831
Shale	831	960
Hard shale	960	1082
Sandy shale	1082	1168
Fine sand	1168	1248
Shale	1248	1254

E. logged by MGS under name of Tallahatchie WA - Jan 25, 72

USGS logged well on Feb 72 report 1972 1972

JR Oct 26-73


OCT 26 1973

MISS. DEPT. OF WATER CONTROL

DRILLERS REMARKS:

If well telescopes please sketch and show depths.

GROUND LEVEL

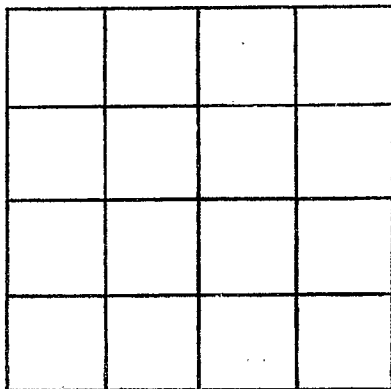

SECTION _____

Please indicate well location X.

ADDITIONAL INFORMATION

If more than one screen,
show locations of each on sketch.