

TALLAHATCHIE
 B 4
 7-3-72

MISSISSIPPI
 BOARD OF WATER COMMISSIONERS
 416 North State Street
 Jackson, Mississippi 39201

WATER WELL DRILLERS LOG

July 3 1972 J B Cain Tallahatchie
 date well completed firm name county well located

LANDOWNER: Mr. Brooks
Enid
 (mailing address)
 WELL LOCATION:
 sec. 15 T 36 N R. 3 E
 S W
2 miles W of Enid
 (distance) (direction) (nearest town)

WELL PURPOSE:
 (home, irrigation, municipal, industrial)

WELL COMPLETION DATA:
 (1) diameter (inches) 4"
 (2) total depth (feet) 270
 (3) static water level (feet) 110 below above top of ground.
 (4) casing Plastic 270,
 (material) (depth)
 (size) If telescope see back.
 (5) screen 10', 360
 (length) (depth to top)
4", Plastic
 (size) (material)
 (6) pump 3A 10
 (HP) (yield gpm)
Fluor
 (type power)
 (7) electric log NO
 (yes or no)
 (organization running log)
 (8) how well bottom plugged Plug

description of formations encountered	from	to
Clay + Sand Str	0	50
Gravel	50	105
Sand	105	130
Blue Clay	130	548
Sand	270	270


DRILLERS REMARKS:

JUL 17 1972

MISS. BO. OF
 WATER COMM.

If well telescopes please sketch and show depths.

GROUND LEVEL

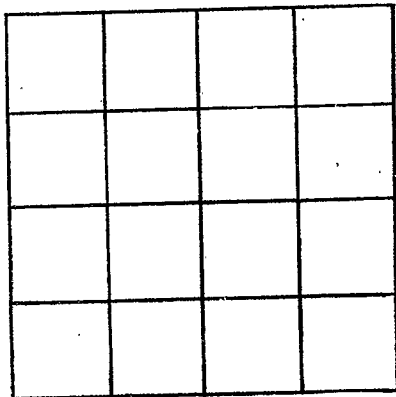

SECTION _____

Please indicate well location X.

ADDITIONAL INFORMATION

If more than one screen,
show locations of each on sketch.