

TALLAHATCHIE
 B6
 12-14-72

MISSISSIPPI
 BOARD OF WATER COMMISSIONERS
 416 North State Street
 Jackson, Mississippi 39201

WATER WELL DRILLERS LOG

CODED

12-14 1972 James R. Lipe Tallahatchie
 date well completed firm name county well located

LANDOWNER: H. B. Benson
 ENid
 MISS.
 (mailing address)

WELL LOCATION:
 sec 7 T 26 N R 3 E
 3 miles N.W. of ENid
 (distance) (direction) (nearest town)

WELL PURPOSE: HOME
 (home, irrigation, municipal, industrial)

WELL COMPLETION DATA:

- (1) diameter (inches) 4
- (2) total depth (feet) 161
- (3) static water level (feet) 80 below top of ground.
- (4) casing PVC, 151 (material) (depth)
 4 (size) if telescope see back.
- (5) screen 10, 151 (length) (depth to top)
 4, PVC (size) (material)
- (6) pump 3/4, 10 (HP) (yield gpm)
 Elec. (type power)
- (7) electric log NO (yes or no)
 no (organization running log)
- (8) how well bottom plugged PVC
 plus

description of formations encountered	from	to
clay	0	20
ll	20	40
Muddy sand	40	56
clay	56	40
ll	40	60
ll	60	80
ll	80	100
ll	100	120
sand and clay	120	140
sand	140	161


CODED

DEC 20 1972

DRILLERS REMARKS:

If well telescopes please sketch and show depths.

GROUND LEVEL

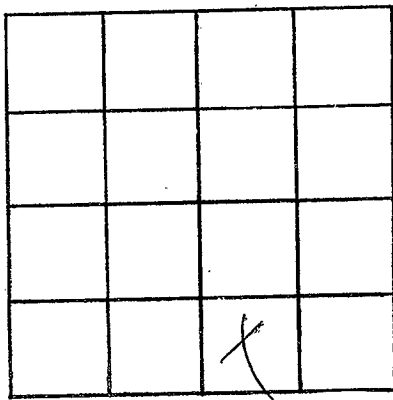

SECTION 7

Please indicate well location X.

ADDITIONAL INFORMATION

If more than one screen,
show locations of each on sketch.