

TALLA.

B 12
8-5-60

WATER WELL DRILLERS LOG

? Tallahatchie

Date: 8-5, 1960, Driller: James R. Lips County: Polk
(Name)

(1) Owner of Land: Edwin Houston
(Name)
Enid
(Address)

(2) Location: $\frac{1}{4}$, $\frac{1}{4}$, Sec. 17 ^{26 3} _{T N R E}
3 miles W, of Enid
(distance) (direction) (Nearest Town)

(3) Topography: _____
(Hilly) (Flat) (Level)

(4) Purpose of Well: Dom
(Domestic Irrigation
Municipal, Industrial, Other)

Description & Color of Materials Sand, Clay, Red Clay, Shell, etc.	Thick- ness Feet	Depth Feet
top clay	15	15
crand	60	75
light sand	15	90
clay	10	100
sand	16	116

Information upon completion of well:

(1) Diameter 2 inches.

(2) Total Depth 116 feet.

(3) Water Level 80 feet below top of ground.

(4) Cased to 110, Size 2


(5) Screen: Size 1 1/4, Length 6

(6) Were any formations sealed against pollution?
_____ yes, no.

If YES depth of formation _____

Why _____

Drillers Remarks: _____

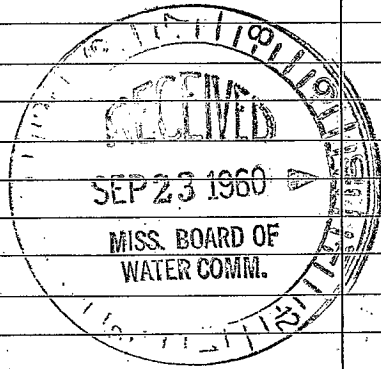

(Use Back Side)

Well No.

