

TALLA,
B 14
10-19-61

WATER WELL DRILLERS LOG

CODED
Dellahatchie
Monaca

Date: 10-19, 1961, Driller: Jas. R. Lipe County: Monaca
(Name)

(1) Owner of Land: Butler Larry Fred
(Name)
Enid, Mich.
(Address)

(2) Location: 1/4, 1/4, Sec. 14 T26 R 7
N W
1 miles West of Enid
(distance) (direction) (Nearest Town)

(3) Topography: Hilly
(Hilly) (Flat) (Level)

(4) Purpose of Well: Domestic
(Domestic Irrigation
Municipal, Industrial, Other)

Description & Color of Materials Sand, Clay, Red Clay, Shell, etc.	Thick- ness Feet	Depth Feet
Clay	0	20
Red bank	20	40
gravel	10	50
compact clay & sand	50	150
solid clay	150	180
expanding band	180	210

Information upon completion of well:

(1) Diameter 2 inches.

(2) Total Depth 210 feet.

(3) Water Level 60' feet below top of ground.

(4) Cased to 186', Size 2"


(5) Screen: Size 1 1/4", Length 6'

(6) Were any formations sealed against pollution?
_____ yes, _____ no.

If YES depth of formation _____

Why _____

Drillers Remarks: _____

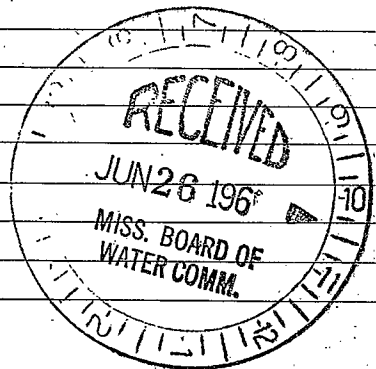

(Use Back Side)

Retain this copy for your office files.

Well No.

