

TALLA.

CODED

B 18

WATER WELL DRILLERS LOG

Tallahatchee

12-27-62

Date: 12 27, 19 62, Driller: James R. Lipe County: Donald

(Name)

Description & Color of Materials Sand, Clay, Red Clay, Shell, etc.	Thick- ness Feet	Depth Feet
SAND & CLAY	0	40
gravel	40	60
Clay & Sand	60	75
water sand	75	120

(1) Owner of Land: B. D. Bailey
(Name)
Charleston, Miss.
(Address)

(2) Location: $\frac{1}{4}$, $\frac{1}{4}$, Sec. 30 $\frac{26}{N}$ $\frac{3}{E}$
6 miles North of Charleston
(distance) (direction) (Nearest Town)

(3) Topography: Hilly
(Hilly) (Flat) (Level)

(4) Purpose of Well: Dom.
(Domestic Irrigation
Municipal, Industrial, Other)


Information upon completion of well:

- (1) Diameter 2 inches.
- (2) Total Depth 120' feet.
- (3) Water Level 80' feet below top of ground.
- (4) Cased to 114, Size 2"
- (5) Screen: Size 1/4, Length 6'
- (6) Were any formations sealed against pollution?
_____ yes, _____ no.

If YES depth of formation _____

Why _____

Drillers Remarks: _____

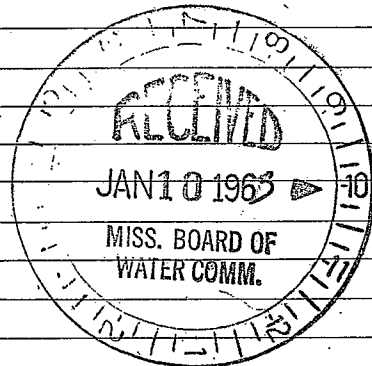

(Use Back Side)

Well No.

