

TALLA.

CODED

B 19
3-7-63

WATER WELL DRILLERS LOG

Date: Mar. 7, 1963, Driller: James P. Lopez County Parola
(Name)

	Description & Color of Materials Sand, Clay, Red Clay, Shell, etc.	Thick- ness Feet	Depth Feet
(1) Owner of Land: <u>F. L. Mabius</u> (Name) <u>Charleston, Miss.</u> (Address)	<u>Clay</u>	<u>0</u>	<u>10</u>
(2) Location: <u>1/4, 1/4, Sec. 27 T26 R3</u> <u>5 miles N. east</u> of <u>Charleston</u> (distance) (direction) (Nearest Town)	<u>clay gravel</u> <u>fine sand</u> <u>pebbles and</u>	<u>10</u> <u>55</u> <u>55</u>	<u>35</u> <u>65</u> <u>89</u>
(3) Topography: <u>level</u> (Hilly) (Flat) (Level)			
(4) Purpose of Well: <u>Domestic</u> (Domestic Irrigation Municipal, Industrial, Other)			


Information upon completion of well:

- (1) Diameter 2 inches.
- (2) Total Depth 89' feet.
- (3) Water Level 45' feet below top of ground.
- (4) Cased to 80, Size 2"
- (5) Screen: Size 1/4, Length 6'
- (6) Were any formations sealed against pollution?
_____ yes, _____ no.

If YES depth of formation _____

Why _____

Drillers Remarks: _____

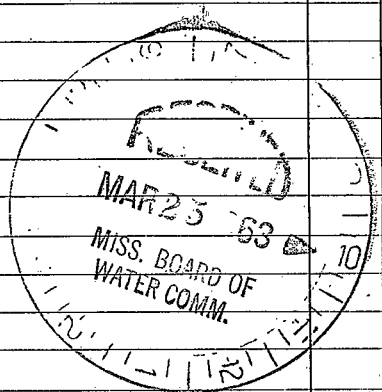

(Use Back Side)

Well No.

