

WATER WELL DRILLERS LOG

TALLA

CODED

Date: 6/3⁰, 1963, Driller: JAMES R. Lipe County: Penola
 (Name)

6-3-63


- (1) Owner of Land: Miner James
 (Name)
Enid
 (Address)
- (2) Location: $\frac{1}{4}$, $\frac{1}{4}$, Sec. 25-26-3 P. R 3 N. E
3 miles South, of Enid
 (distance) (direction) (Nearest Town)
- (3) Topography: Hilly
 (Hilly) (Flat) (Level)
- (4) Purpose of Well: Domestic
 (Domestic Irrigation, Municipal, Industrial, Other)

Description & Color of Materials Sand, Clay, Red Clay, Shell, etc.	Thick- ness Feet	Depth Feet
<u>Clay & Sand</u>	<u>0</u>	<u>25</u>
<u>Silt & gravel</u>	<u>25</u>	<u>40</u>
<u>Sand</u>	<u>40</u>	<u>53</u>
<u>W/leaving Sand</u>	<u>55</u>	<u>73</u>

Information upon completion of well:

- (1) Diameter 2 inches.
- (2) Total Depth 73 feet.
- (3) Water Level 40 feet below top of ground.
- (4) Cased to 65, Size 2"
- (5) Screen: Size 1/4, Length 6
- (6) Were any formations sealed against pollution?
 _____ yes, _____ no.

If YES depth of formation _____
 Why _____
 Drillers Remarks: _____

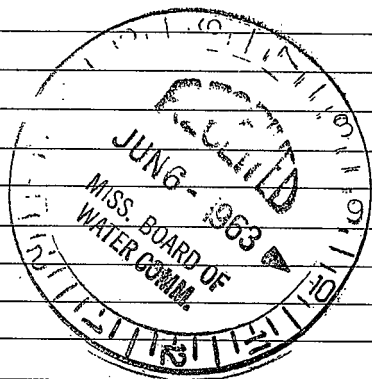

(Use Back Side)

Well No.

Retain this copy for your office files.

Date: _____, 19____, Driller: _____ County _____

(Name)

	Description & Color of Materials Sand, Clay, Red Clay, Shell, etc.	Thick- ness Feet	Depth Feet
(1) Owner of Land: _____ (Name)			
_____ (Address)			
(2) Location: _____ 1/4, _____ 1/4, Sec. _____ T _____ R _____, _____ miles _____, of _____ (distance) (direction) (Nearest Town)			
(3) Topography: _____ (Hilly) (Flat) (Level)			
(4) Purpose of Well: _____ (Domestic Irrigation Municipal, Industrial, Other)			
Information upon completion of well:			
(1) Diameter _____ inches.			
(2) Total Depth _____ feet.			
(3) Water Level _____ feet below top of ground.			
(4) Cased to _____, Size _____,			
(5) Screen: Size _____, Length _____.			
(6) Were any formations sealed against pollution? _____ yes, _____ no.			
If YES depth of formation _____,			
Why _____			
Drillers Remarks: _____			

(Use Back Side)

Well No.

Retain this copy for your office files.