

TALLAHASSEE WATER WELL DRILLERS LOG CODED

Date: Jan 11 1964, Driller: Jimmie R. Lynn County: Florida
1-9-64 (Name)

(1) Owner of Land: Smith Glenn
(Name)
Enid Miss
(Address)

(2) Location: 1/4, 1/4, Sec. 18 26 3
(distance) (direction) (Nearest Town)
5 miles West of Enid

(3) Topography: Hilly
(Hilly) (Flat) (Level)

(4) Purpose of Well: Domestic
(Domestic Irrigation Municipal, Industrial, Other)

Description & Color of Materials Sand, Clay, Red Clay, Shell, etc.	Thick- ness Feet	Depth Feet
<u>Clay</u>	<u>0</u>	<u>30</u>
<u>Gravel</u>	<u>30</u>	<u>50</u>
<u>Gravelly Sand</u>	<u>50</u>	<u>75</u>
<u>Black Sand</u>	<u>75</u>	<u>91</u>
<u>Water Bearing Sand</u>	<u>96</u>	<u>124</u>

Information upon completion of well:

(1) Diameter 2 inches.

(2) Total Depth 126' feet.


(3) Water Level 60' feet below top of ground.

(4) Cased to 117, Size 2.

(5) Screen: Size 1/4, Length 6'.

(6) Were any formations sealed against pollution?
 yes, no.

If YES depth of formation _____
 Why _____
 Drillers Remarks: _____

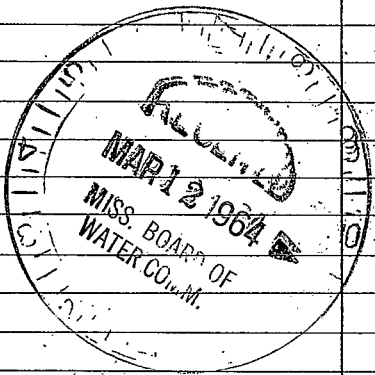

Retain this copy for your office files.

(Use Back Side)

Well No. 27

