

TALLAHATCHIE

B25

MISSISSIPPI BOARD OF WATER COMMISSIONERS CODED

7-66

WATER WELL DRILLERS LOG

Date: 7-28, 1966, Driller: James K. Lepe Tallahatchie
Frank Zylon County: DeWitt
(When well drilled) (Name) (Where well is located)

(1) Owner of Land: W & Burkhalter
Emid
(Name) (Address)

Description & Color of Materials Sand, Clay, Red Clay, Shell, etc.	Thick- ness Feet	Depth Feet
Clay	0	55
Clay & gravel	55	80
gravel & sand	80	110
Sand	110	150
w/sand	150	178

(2) Location: 1/4, 1/4, Sec. 14 T19N
1 miles West of Emid
(distance) (direction) (Nearest Town)

(3) Topography: Hilly
(Hilly) (Flat) (Level)

(4) Purpose of Well: Dom.
(Domestic Irrigation
Municipal, Industrial, Other)

Information upon completion of well:

- (1) Diameter 12 inches.
- (2) Total Depth 178' feet.
- (3) Water Level 125' feet below top of ground.
- (4) Cased to 108', Size 2"
- (5) Screen: Size 1 1/4", Length 6'
- (6) Were any formations sealed against pollution?

yes, no.

If YES depth of formation _____


Why _____

Drillers Remarks: _____

Yield in gpm: 10

Size pump: 3/4

Type power: _____

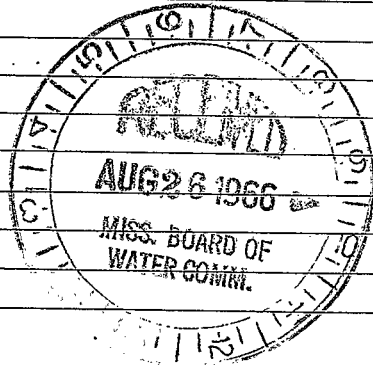

Mail this copy to Board of Water Commissioners 429 Miss. St. Jackson, Miss.

