

CODED

TALLHATCHIE

B 26

3-68

MISSISSIPPI BOARD OF WATER COMMISSIONERS
416 North State Street
Jackson, Mississippi 39201

WATER WELL DRILLERS LOG

March 1

date well completed

James R. Lipe

firm name

Tallahatchie

county well located

LANDOWNER: Ray Swallen

description of formations encountered

from

to

land

TOP SOIL

0 20

Red clay

20 40

Red sand

40 60

Gravel

60 80

Clay

80 100

Clay

100 120

Clay

120 140

Sand and Clay

140 160

Water sand

160 183

WELL LOCATION:

sec. 7 T. 26 N. R. 3 E. S. W.
3 miles N. of Dandridge
(distance) (direction) (nearest town)

WELL PURPOSE:

(home, irrigation, municipal, industrial)

WELL COMPLETION DATA:

(1) diameter (inches) 4

(2) total depth (feet) 183

(3) static water level (feet) below above top of ground.

(4) casing Plastic, 183, (material) (depth)

(size) If telescope see back.

(5) screen 11, 172 (length) (depth, to top)

4, plastic (size) (material)

(6) pump 3/4, 20 (HP) (yield gpm)


Electric (type power)

(7) electric log no (yes or no)

(organization running log)


(8) how well bottom plugged Plastic Cap

DRILLERS REMARKS:

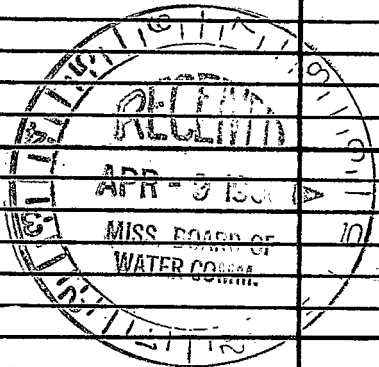

If well telescopes please sketch and show depths.

GROUND LEVEL

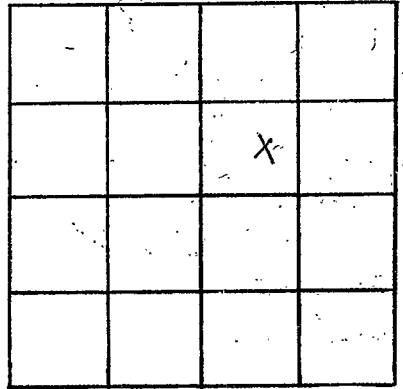

SECTION _____

Please indicate well location X.

ADDITIONAL INFORMATION

If more than one screen,
show locations of each on sketch.