

CODED

Tallahatchie  
B 27  
12-68

MISSISSIPPI  
BOARD OF WATER COMMISSIONERS  
416 North State Street  
Jackson, Mississippi 39201

WATER WELL DRILLERS LOG

1968 James B. Lipe Tallahatchie  
date well completed firm name county well located

LANDOWNER: Jessie Beard  
Enid  
Miss.  
(mailing address)

description of formations encountered	from	to
Clay	0	20
sand	20	40
Gravel	40	60
sand and gravel	60	80
sand	80	91

WELL LOCATION:  
sec. 28 T. 26 (N) R. 3 (E)  
5 miles S.W. of Enid  
(distance) (direction) (nearest town)

WELL PURPOSE: home  
(home, irrigation, municipal, industrial)

WELL COMPLETION DATA:

- (1) diameter (inches) 4"
- (2) total depth (feet) 91
- (3) static water level (feet) 25 below above top of ground.
- (4) casing Plastic 83  
(material) (depth)  
8' if telescope see back.  
(size)
- (5) screen 8' 83'  
(length) (depth to top)  
4 Plastic  
(size) (material)
- (6) pump 1/2 20  
(HP) (yield gpm)  
Elec.  
(type power)
- (7) electric log no  
(yes or no)

(organization running log)


(8) how well bottom plugged 4"  
Plastic Plug

DRILLERS REMARKS:

JAN 3 1969  
MISSISSIPPI  
WATER BOARD

If well telescopes please sketch and show depths.

GROUND LEVEL

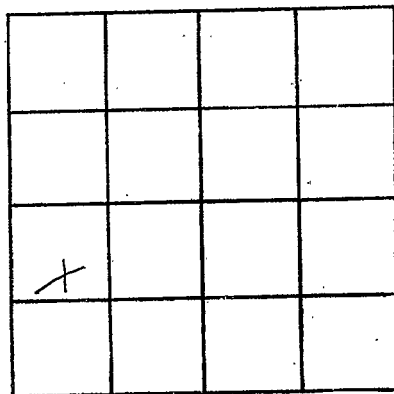

SECTION 28

Please indicate well location X.

ADDITIONAL INFORMATION

If more than one screen, show locations of each on sketch.