

CODED

Tallahatchie
B30
7-15-69

MISSISSIPPI
BOARD OF WATER COMMISSIONERS
416 North State Street
Jackson, Mississippi 39201

WATER WELL DRILLERS LOG

7, 15 1969 James R. Lipe Tallahatchie
date well completed firm name county well located

LANDOWNER: Irene Howard

description of formations encountered

from to

Enid Miss.
(mailing address)

Clay
sand and clay
gravel
sand
ll

0 20
20 40
40 60
60 80
80 100
100 126

WELL LOCATION:

sec 9 T 14 N R 3 E
3 miles N.W. of Enid
(distance) (direction) (nearest town)

WELL PURPOSE: HOME
(home, irrigation, municipal, industrial)

WELL COMPLETION DATA:

- (1) diameter (inches) 4"
- (2) total depth (feet) 126
- (3) static water level (feet) 90 below top of ground.
- (4) casing Plastic 118 (material) (depth)
4 (size) if telescope see back.
- (5) screen 8 118 (length) (depth to top)
4" Plastic (size) (material)
- (6) pump 3/4 8 (HP) (yield gpm)
Elec. (type power)
- (7) electric log no (yes or no)
no (organization running log)

(8) how well bottom plugged with Plastic Plug


DRILLERS REMARKS:

OCT 20 1969

MISS. BD. OF WATER COM.

If well telescopes please sketch and show depths.

GROUND LEVEL

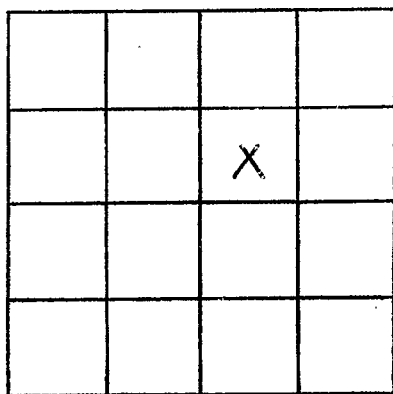

SECTION 9

Please indicate well location X.

ADDITIONAL INFORMATION

If more than one screen, show locations of each on sketch.