

CODED

Jalalatchie
B32
8-12-69

MISSISSIPPI
BOARD OF WATER COMMISSIONERS
416 North State Street
Jackson, Mississippi 39201

WATER WELL DRILLERS LOG

Aug 12 1969 Roberson Well Drilling Co. Jalalatchie
date well completed firm name county well located

LANDOWNER: George Kouroussis

| description of formations encountered | from | to |
|---------------------------------------|------------|------------|
| <u>Red Clay</u> | <u>0</u> | <u>30</u> |
| <u>Red Clay + sand</u> | <u>30</u> | <u>40</u> |
| <u>gravel</u> | <u>40</u> | <u>80</u> |
| <u>gravel + sand</u> | <u>80</u> | <u>100</u> |
| <u>sand</u> | <u>100</u> | <u>110</u> |

Enid, Miss
(mailing address)

WELL LOCATION:
sec. 4 T. 26^N R. 3^E
4 miles NW of Enid
(distance) (direction) (nearest town)

WELL PURPOSE: home
(home, irrigation, municipal, industrial)

WELL COMPLETION DATA:

- (1) diameter (inches) 4"
- (2) total depth (feet) 110
- (3) static water level (feet) 85 below above top of ground.
- (4) casing Plastic, 105
(material) (depth)
4"
(size) If telescope see back.
- (5) screen 5 ft 105
(length) (depth to top)
4"
(size) gravel
(material)
- (6) pump 34 10
(HP) (yield gpm)
220
(type power)
- (7) electric log no
(yes or no)

(organization running log)

(8) how well bottom plugged Cased


OCT 22 1969

MISS. Bd. of
WATER COMMISSIONERS

DRILLERS REMARKS: Plastic Water Well

If well telescopes please sketch and show depths.

GROUND LEVEL

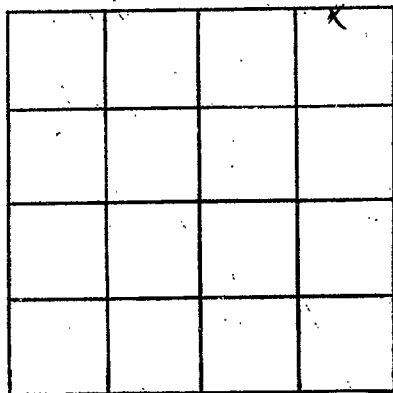

SECTION 4

Please indicate well location X.

ADDITIONAL INFORMATION

If more than one screen,
show locations of each on sketch.