

CODED

TALLAHATCHIE
B 34
11-5-69

MISSISSIPPI
BOARD OF WATER COMMISSIONERS
416 North State Street
Jackson, Mississippi 39201

WATER WELL DRILLERS LOG

No. 5 1969 LIFE WELL CO. TALLAHATCHIE
date well completed firm name county well located

LANDOWNER:	description of formations encountered	from	to
<u>Travis Matthews</u> <u>Enid, Miss.</u> (mailing address)			
WELL LOCATION: <u>sec. 19 T 26 N R 3 E</u> <u>5 miles W of Enid</u> (distance) (direction) (nearest town)			
WELL PURPOSE: <u>home</u> (home, irrigation, municipal, industrial)			
WELL COMPLETION DATA:			
(1) diameter (inches) <u>4"</u>			
(2) total depth (feet) <u>146'</u>			
(3) static water level (feet) _____ below above top of ground.			
(4) casing <u>PVC</u> , <u>142'</u> (material) (depth) <u>4"</u> if telescope see back. (size)			
(5) screen <u>4'</u> , <u>142'</u> (length) (depth to top) <u>4"</u> , <u>PVC + silica</u> (size) (material)			
(6) pump <u>1/2</u> , <u>10</u> (HP) (yield gpm) <u>electric</u> (type power)			
(7) electric log <u>NO</u> (yes or no) <u>✓</u> (organization running log)			
(8) how well bottom plugged <u>PVC cap</u>			
DRILLERS REMARKS:			

NOV 12 1969


MISS. Bd. of
WATER COMMISSIONERS

NOV 14 1969

MISS. Bd. of
WATER COMMISSIONERS

If well telescopes please sketch and show depths.

GROUND LEVEL

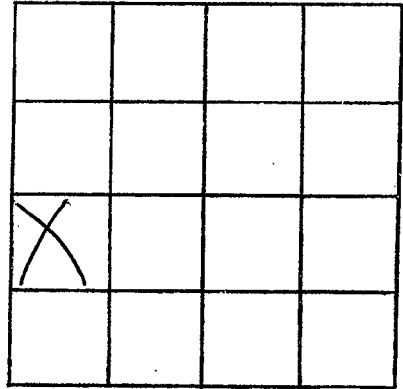

SECTION 19

Please indicate well location X.

ADDITIONAL INFORMATION

Lined area for additional information.

If more than one screen, show locations of each on sketch.