

Tallahatchie
 B 36
 3-10-70

MISSISSIPPI
 BOARD OF WATER COMMISSIONERS
 416 North State Street
 Jackson, Mississippi 39201

CODED

WATER WELL DRILLERS LOG

MAR 10 1970 LIPE WELL CO. TALLAHATCHIE
 date well completed firm name county well located

LANDOWNER:
 EARL HOWARD
 ENID, MISS
 (mailing address)

WELL LOCATION:
 sec. 26 T 26 S R 3 E
 3 miles W of ENID
 (distance) (direction) (nearest town)

WELL PURPOSE: home
 (home, irrigation, municipal, industrial)

WELL COMPLETION DATA:
 (1) diameter (inches) 4"
 (2) total depth (feet) 176'
 (3) static water level (feet) 120' below top of ground.
 (4) casing PVC, 168' (material) (depth)
 4" (size) If telescope see back.
 (5) screen 8' length, 168' depth to top
 4" PVC + SILICA (size) (material)
 (6) pump 3/4 HP, 9 (yield gpm)
 elec (type power)
 (7) electric log no (yes or no)
 (organization running log)
 (8) how well bottom plugged PVC cap

description of formations encountered	from	to
top soil + sand	0	20
sand + gravel	20	40
sand + gravel	40	60
clay	60	80
clay	80	100
clay	100	120
clay	120	140
clay + sand	140	160
sand	160	180

CODED


APR 20 1970

MISS. BD. OF WATER COMM.

DRILLERS REMARKS:

If well telescopes please sketch and show depths.

GROUND LEVEL

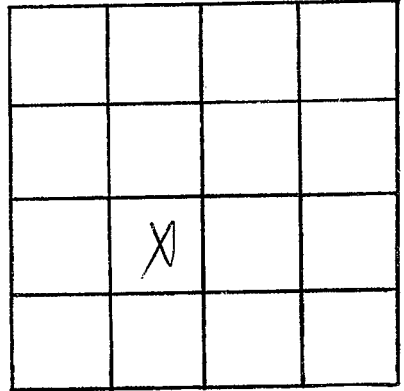

SECTION 26

Please indicate well location X.

ADDITIONAL INFORMATION

If more than one screen, show locations of each on sketch.