

TALLAHATCHIE
B38
8-20-70

MISSISSIPPI
 BOARD OF WATER COMMISSIONERS
 416 North State Street
 Jackson, Mississippi 39201

CODED

WATER WELL DRILLERS LOG

Aug 20 1970 Lipe Well Co Tallahatchie
 date well completed firm name county well located

LANDOWNER:
Enid school
Enid Miss,
 (mailing address)

WELL LOCATION:
 sec. 23 T 26 N R 3 E
1/4 miles west of Enid
 (distance) (direction) (nearest town)

WELL PURPOSE: School
 (home, irrigation, municipal, industrial)

WELL COMPLETION DATA:

- (1) diameter (inches) 4
- (2) total depth (feet) 211
- (3) static water level (feet) 60 below above top of ground.
- (4) casing PVC 201
 (material) (depth)
4 If telescope see back.
 (size)
- (5) screen 10 201
 (length) (depth to top)
4 PVC
 (size) (material)
- (6) pump 3/4 20
 (HP) (yield gpm)
Elec.
 (type power)
- (7) electric log no
 (yes or no)
no
 (organization running log)
- (8) how well bottom plugged PVC
plug

description of formations encountered	depth	
	from	to
<u>clay</u>	<u>0</u>	<u>20</u>
<u>sand and gravel</u>	<u>20</u>	<u>40</u>
<u>clay and sand</u>	<u>40</u>	<u>60</u>
<u>ll ll ll</u>	<u>60</u>	<u>80</u>
<u>ll ll ll</u>	<u>80</u>	<u>100</u>
<u>clay</u>	<u>100</u>	<u>120</u>
<u>ll</u>	<u>120</u>	<u>140</u>
<u>ll</u>	<u>140</u>	<u>160</u>
<u>ll</u>	<u>160</u>	<u>180</u>
<u>sand</u>	<u>180</u>	<u>200</u>
<u>ll</u>	<u>200</u>	<u>211</u>

CODED


AUG 24 1970

DRILLERS REMARKS:

MISS. BD. OF
 WATER COMM.

If well telescopes please sketch and show depths.

GROUND LEVEL

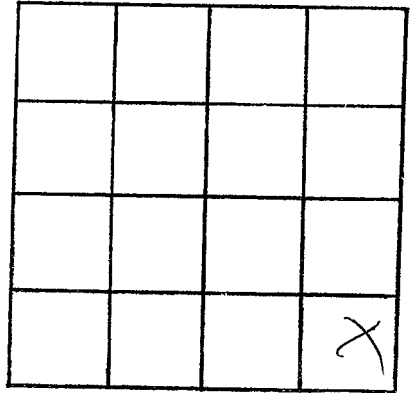

SECTION 23

Please indicate well location X.

ADDITIONAL INFORMATION

If more than one screen,
show locations of each on sketch.