

TALLAHATCHIE

B39

12-8-70

MISSISSIPPI BOARD OF WATER COMMISSIONERS
416 North State Street
Jackson, Mississippi 39201

CODED

WATER WELL DRILLERS LOG

12-8
date well completed

1970 James R. Lipe
firm name

Tallahatchie
county well located

LANDOWNER:	description of formations encountered	from	to
Jeroy Hankins	Clay	0	20
ENid MISS	"	20	40
(mailing address)	"	40	60
WELL LOCATION:	Sand and Gravel	60	80
sec. 6 T 26 N R 3 E	Clay	80	100
6 miles west of Pope	"	100	120
(distance) (direction) (nearest town)	"	120	140
WELL PURPOSE: HOME	Fine sand	140	160
(home, irrigation, municipal, industrial)	Sand and Clay	160	180
WELL COMPLETION DATA:	Sand	180	200
(1) diameter (inches) 4	"	200	212
(2) total depth (feet) 212			
(3) static water level (feet) 80 below top of ground.			
(4) casing PVC 202 (material) (depth)			
4 (size) if telescope see back.			
(5) screen 10 202 (length) (depth to top)			
4 PVC (size) (material)			
(6) pump 3/4 10 (HP) (yield gpm)			
Elec. (type power)			
(7) electric log no (yes or no)			
no (organization running log)			
(8) how well bottom plugged PVC Plug			
DRILLERS REMARKS:			


CODED

JAN 26 1971

MISS. Bd. OF WATER COMM.

If well telescopes please sketch and show depths.

GROUND LEVEL

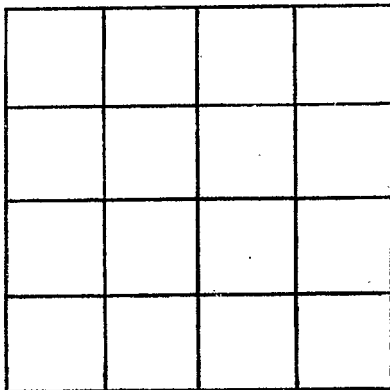

SECTION _____

Please indicate well location X.

ADDITIONAL INFORMATION

If more than one screen, show locations of each on sketch.