

MISSISSIPPI DEPARTMENT OF NATURAL RESOURCES
Bureau of Land and Water Resources
 Southport Mall
 P.O. Box 10631
 Jackson, Mississippi 39209
WATER WELL DRILLERS LOG

CODED

Tallahatchie
 CL-2355 **B41**
5-3-83

5-3 19 83 LAYNE CENTRAL CO. TALLAHATCHIE
 date well completed firm name county well located

LANDOWNER:
 NORTH TALLAHATCHIE WATER ASSN.
 Charleston, MS
 (mailing address)

description of formations encountered	from	to
clay	0	38
gravel & sand	38	116
hard white clay	116	155
shale	155	212
hard lignite shale	212	230
sandy shale	230	420
rock	420	421
hard shale	421	575
shale	575	696
sandy shale	696	748
shale	748	910
sandy shale	910	952
shale	952	967
sand	967	997
shale	997	1095
sandy shale	1095	1140
hard shale	1140	1184
sandy shale	1184	1194
fine sand	1194	1254
sandy shale	1254	1300

WELL LOCATION:
 sec. 26 N R. 3E W
8 miles N of Charleston
 (distance) (direction) (nearest town)

WELL PURPOSE: municipal
 (home, irrigation, municipal, industrial)

WELL COMPLETION DATA:

- (1) diameter (inches) 28"
- (2) total depth (feet) 1264'
- (3) static water level (feet) 210' below top of ground.
- (4) casing steel 1190'
 (material) (depth)
12"
 (size) if telescope see back.
- (5) screen 70'9" 1190'
 (length) (depth to top)
8" st. steel
 (size) (material)
- (6) pump 100 500
 (HP) (yield gpm)
 electric
 (type power)
- (7) electric log yes
 (yes or no)
 MSGS
 (organization running log)
- (8) how well bottom plugged BP valve

DRILLERS REMARKS:

CODED


DEPT. OF NATURAL RESOURCES
 BUREAU OF LAND & WATER RESOURCES

OCT 10 1983

RECEIVED

If well telescopes please sketch and show depths.

GROUND LEVEL

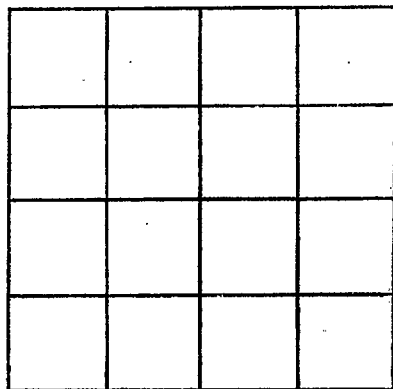

SECTION _____

Please indicate well location X.

ADDITIONAL INFORMATION

If more than one screen, show locations of each on sketch.