

Dallahatler
~~Perkins~~

MISSISSIPPI
BOARD OF WATER COMMISSIONERS
416 North State Street
Jackson, Mississippi 39201

WATER WELL DRILLERS LOG

Dallahatler

4/2/84
date well completed

19 Sipe Well & Supply
firm name

~~Perkins~~
county well located

LANDOWNER: *LC Mobus*

Emil

Miss

(mailing address)

WELL LOCATION: *4*

sec *35* T *9* R *20*
3 miles *N* of *Enid*
(distance) (direction) (nearest town)

WELL PURPOSE:
(home, irrigation, municipal, industrial)

WELL COMPLETION DATA:

- (1) diameter (inches) *4*
- (2) total depth (feet) *150*
- (3) static water level (feet) *2* below
above
top of ground.
- (4) casing *PVC* *140*
(material) (depth)
4 if telescope see back.
(size)
- (5) screen *10* *140*
(length) (depth to top)
4 *PVC*
(size) (material)
- (6) pump *1/2* *30*
(HP) (yield gpm)
Elec
(type power)
- (7) electric log *N*
(yes or no)
A
(organization running log)
- (8) how well bottom plugged *PVC*
Cap

description of formations encountered

from

to

Dang & clay
clay
sand

0 *60*
60 *140*
140 *150*

DEPT. OF NATURAL RESOURCES
BUREAU OF LAND & WATER RESOURCES


APR 23 1984

RECEIVED

DRILLERS REMARKS:

If well telescopes please sketch and show depths.

GROUND LEVEL

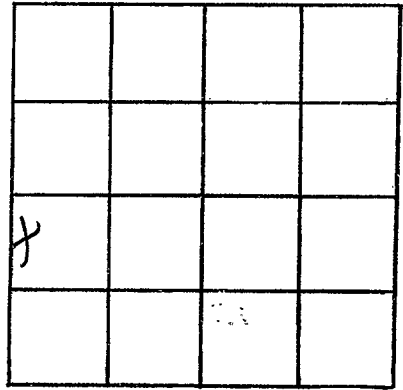

SECTION _____

Please indicate well location X.

ADDITIONAL INFORMATION

If more than one screen,
show locations of each on sketch.