

Jallahatines
B 2002

MISSISSIPPI
BOARD OF WATER COMMISSIONERS
416 North State Street
Jackson, Mississippi 39201

WATER WELL DRILLERS LOG

Jallahatines
Pope

2, 27, 84 19
date well completed

Lipe Well Supply
firm name

county well located

LANDOWNER: William Poyett

R41 Bx 218A

Erin Ms

(mailing address)

WELL LOCATION:

sec. 13 T 26 N R 3 E
S
7 miles S of Pope
(distance) (direction) (nearest town)

WELL PURPOSE: home
(home, irrigation, municipal, industrial)

WELL COMPLETION DATA:

- (1) diameter (inches) 4
- (2) total depth (feet) 100
- (3) static water level (feet) 75 ^(below) above top of ground.
- (4) casing PVC 90
(material) (depth)
4 If telescope see back.
(size)
- (5) screen 10 90
(length) (depth to top)
4 PVC
(size) (material)
- (6) pump 3/4 10
(HP) (yield gpm)
Elec
(type power)
- (7) electric log No
(yes or no)
(organization running log)
- (8) how well bottom plugged PVC cap

description of formations encountered

from

to

Clay
Sand clay
Sand

0 20
20 60
60 100

DRILLERS REMARKS:


DEPT. OF NATURAL RESOURCES
BUREAU OF LAND & WATER RESOURCES

APR 23 1984

RECEIVED

If well telescopes please sketch and show depths.

GROUND LEVEL

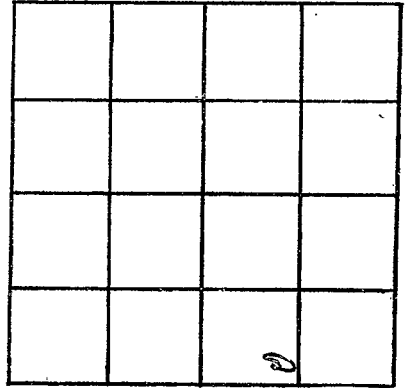

SECTION _____

Please indicate well location X.

ADDITIONAL INFORMATION

If more than one screen, show locations of each on sketch.