

C3

12-20-61

WATER WELL DRILLERS LOG CODED

9

Date: DEC 20, 1961, Driller: DELTA DRILLING Co. County TALLAHATCHIE

(Name)

	Description & Color of Materials Sand, Clay, Red Clay, Shell, etc.	Thick- ness Feet	Depth Feet
(1) Owner of Land: <u>BILLY J WILLIAMS</u> (Name)	GUMBO	42	42
<u>TUTWILER, MISS.</u> (Address)	SAND	41	83
(2) Location: <u>NE 1/4, SW 1/4, Sec. 29 T25R2W</u> <u>SO SIDE INTERSECTION OF HIGHWAYS</u> <u>U.S. 49 W + 49 E</u> miles (distance), of <u>TUTWILER</u> , (direction) (Nearest Town)	GRAVEL	65	148
	SAND	43	191
	GUMBO	21	212
	SAND	127	339
(3) Topography: <u>DELTA</u> (Hilly) (Flat) (Level)	GUMBO	107	446
	SAND	84	530
(4) Purpose of Well: <u>DOMESTIC</u> (Domestic Irrigation Municipal, Industrial, Other)	SHALE	84	614
	GREEN SAND W/HARD ROCK	107	721
	GUMBO	104	825
	SHADED	60	885
	WHITE SAND	23	908
	SHALE	80	988
	WHITE SAND	53	1041


Information upon completion of well:

- (1) Diameter 3 inches.
- (2) Total Depth 1041 feet.
- (3) Water Level WELL FLOWS feet below top of ground.
- (4) Cased to 1041', Size 3x2"
- (5) Screen: Size 2, Length 20'
- (6) Were any formations sealed against pollution?
_____ yes, _____ no.

If YES depth of formation _____

Why _____

Drillers Remarks: _____

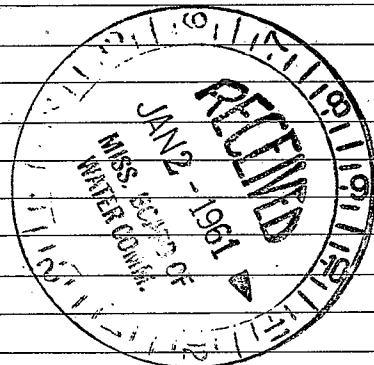

(Use Back Side)

Well No.

