


Tallahatchie
C7
4-67

MISSISSIPPI
BOARD OF WATER COMMISSIONERS

416 North State Street
Jackson, Mississippi 39201

WATER WELL DRILLERS LOG

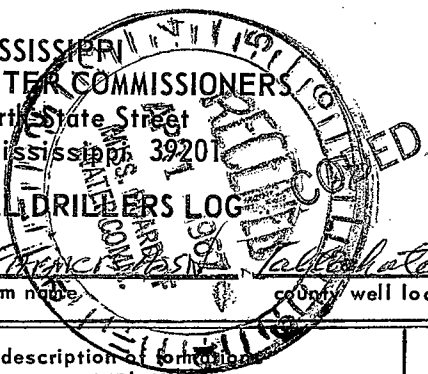

7-67 1975 Five County Branches Tallahatchie
date well completed firm name county well located

LANDOWNER: M. L. MITCHELL

Fertilizer Miss
(mailing address)

WELL LOCATION:

sec 19 T 25 N R 2
1/4 miles W of Fertilizer
(distance) (direction) (nearest town)

WELL PURPOSE: Irrigation
(home, irrigation, municipal, industrial)

WELL COMPLETION DATA:

- (1) diameter (inches) 6"
- (2) total depth (feet) 105' 10"
- (3) static water level (feet) 20' below top of ground.
- (4) casing Pipe 57' 10"
(material) (depth)
- (5) screen 48" 57' 10"
(length) (depth to top)
6" Doerr
(size) (material)
- (6) pump 30th Labs 1000
(HP) (yield gpm)
Inerta
(type power)
- (7) electric log No
(yes or no)

(organization running log)

(8) how well bottom plugged welded

description of formations encountered	from	to
Top Soil - trace sand		20'
FINE SAND	6 1/2'	27'
MED SAND	26'	53'
FINE SAND	6 1/2'	59 1/2'
MED	6 1/2'	66'
Sand + Gravel	45'	111'
SOLID ROCK		

CODED

DRILLERS REMARKS:

If well telescopes please sketch and show depths.

GROUND LEVEL

19

	X		

SECTION _____

Please indicate well location X.

ADDITIONAL INFORMATION

If more than one screen, show locations of each on sketch.