

TALLAHATCHIE
 C-18
 7-9-71

MISSISSIPPI
 BOARD OF WATER COMMISSIONERS
 416 North State Street
 Jackson, Mississippi 39201

CODED

C3514

WATER WELL DRILLERS LOG

July 9, 1971 SINGER- Layne Central Division Tallahatchie
 date well completed firm name county well located


LANDOWNER:	description of fomations encountered	from	to
Yandell Brothers	Clay	07	25
Vance, Mississippi	Sand	25	40
(mailing address)	Coarse sand	40	48
WELL LOCATION:	Coarse sand & Pea gravel	48	68
sec. 1 T. 25 N R. 2 W	Coarse sand & gravel	68	94
miles of Vance			
(distance) (direction) of (nearest town)			
WELL PURPOSE: irrigation			
(home, irrigation, municipal, industrial)			
WELL COMPLETION DATA:			
(1) diameter (inches) 16			
(2) total depth (feet) 92			
(3) static water level (feet) 12' below top of ground.			
(4) casing steel, 52' (material), (depth)			
16" (size) if telescope see back.			
(5) screen 40' (length), 92' (depth to top)			
16" (size), Armco (material)			
(6) pump 50 (HP), 2000 (yield gpm)			
engine (type power)			
(7) electric log no (yes or no)			
(organization running log)			
(8) how well bottom plugged plate			
DRILLERS REMARKS:			

CODED

7-9-71
 SINGER- LAYNE
 CENTRAL DIVISION

If well telescopes please sketch and show depths.

GROUND LEVEL

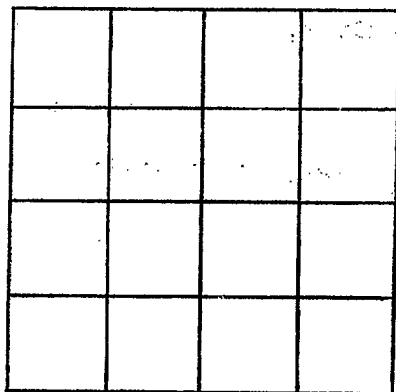

SECTION _____

Please indicate well location X.

ADDITIONAL INFORMATION

If more than one screen,
show locations of each on sketch.