

Jallahatchie
 C 23
 8-68

MISSISSIPPI
 BOARD OF WATER COMMISSIONERS
 416 North State Street
 Jackson, Mississippi 39201 **CODED**

WATER WELL DRILLERS LOG

8-26-68 date well completed Wide County, Tennessee - Jallahatchie firm name county well located

LANDOWNER: William J. Joplin

Service
Leetwater Mills
 (mailing address)

WELL LOCATION:

sec. 29 T. 25 N. R. 2 E. W
1/2 miles S of Leetwater
 (distance) (direction) (nearest town)

WELL PURPOSE:

Domestic
 (home, irrigation, municipal, industrial)

WELL COMPLETION DATA:


- (1) diameter (inches) 4
- (2) total depth (feet) 67
- (3) static water level (feet) 13 ⁵ below top of ground.
- (4) casing PVC, 67,
 (material) (depth)
4 if telescope see back.
 (size)
- (5) screen 20, 67
 (length) (depth to top)
4, Plastic
 (size) (material)
- (6) pump 3, 50
 (HP) (yield gpm)
3
 (type power)
- (7) electric log _____
 (yes or no)

 (organization running log)

(8) how well bottom plugged
with valve


DRILLERS REMARKS:

description of formations encountered	from	to
<u>Clay</u>		<u>37</u>
<u>Sand & gravel</u>	<u>1</u>	<u>00</u>

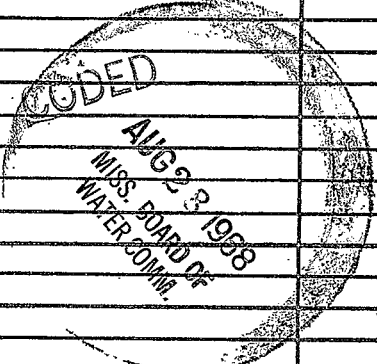

If well telescopes please sketch and show depths.

GROUND LEVEL

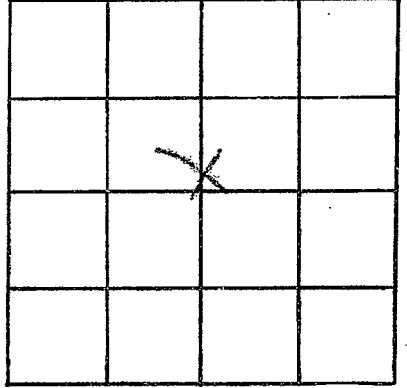

SECTION 29

Please indicate well location X.

ADDITIONAL INFORMATION

If more than one screen,
show locations of each on sketch.