

Tallahatchie
C29
7-18-75

MISSISSIPPI
BOARD OF WATER COMMISSIONERS
416 North State Street
Jackson, Mississippi 39201

CODED

WATER WELL DRILLERS LOG

7-18-75 19 date well completed BUTANE GAS CO. OF GREENWOOD Tallahatchie firm name county well located

LANDOWNER: PAUL PENNINGTON
Summer (mailing address)
WELL LOCATION: sec. 36 T 25 N R 2 W
2 miles NE of Summer (distance) (direction) (nearest town)

description of formations encountered	from	to
SAND	0	20
CLAY	20	80
SAND + GRAVEL	80	114

CODED

WELL PURPOSE: IRR. (home, irrigation, municipal, industrial)

WELL COMPLETION DATA:
(1) diameter (inches) 16
(2) total depth (feet) 114
(3) static water level (feet) 18 below top of ground.
(4) casing Steel 74 (material) (depth) 16 (size) If telescope see back.
(5) screen 40 74 (length) (depth to top) 16 Steel (size) (material)
(6) pump 60 3000 (HP) (yield gpm) Diesel (type power)
(7) electric log No (yes or no)
(organization running log)
(8) how well bottom plugged Steel Plate


DRILLERS REMARKS:

AUG 19 1975

MISS. BD. OF WATER COMMISSIONERS

If well telescopes please sketch and show depths.

GROUND LEVEL

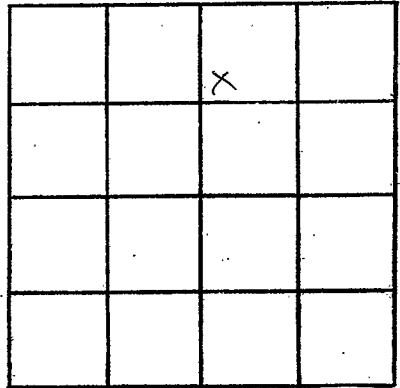

SECTION 36

Please indicate well location X.

ADDITIONAL INFORMATION

If more than one screen, show locations of each on sketch.