

TALLAHATCA, E
 C30
 6-16-76

MISSISSIPPI
 BOARD OF WATER COMMISSIONERS
 416 North State Street
 Jackson, Mississippi 39201

WATER WELL DRILLERS LOG

Tall.

6-16 date well completed 1976 Delta Well Supply firm name Polk county well located

LANDOWNER:
 Bill Williams
 Tutwiler, Miss.
 (mailing address)

description of formations encountered	from	to
Top soil	0	22
fine sand	22	42
clay	42	46
coarse sand	46	80
Coarse sand & gravel	80	105
Bottom in clay		105

WELL LOCATION:
 sec. 29 T. 25 N. R. 2 E. W.
 1 miles S.E. of Tutwiler
 (distance) (direction) (nearest town)

WELL PURPOSE: Irrigation
 (home, irrigation, municipal, industrial)

- WELL COMPLETION DATA:
- (1) diameter (inches) 16
 - (2) total depth (feet) 105
 - (3) static water level (feet) 24 below top of ground.
 - (4) casing 16" (material) Steel (depth)
 - (5) screen 40' (length) 20' (depth to top) 16" (size) Steel (material)
 - (6) pump 100 (HP) 2800 (yield gpm) 2000 (type power)
 - (7) electric log no (yes or no)

(8) how well bottom plugged Steel Pipe

DRILLERS REMARKS:


RECEIVED

JUL 19 1976

MISS. BD. OF WATER COMM.

If well telescopes please sketch and show depths.

GROUND LEVEL

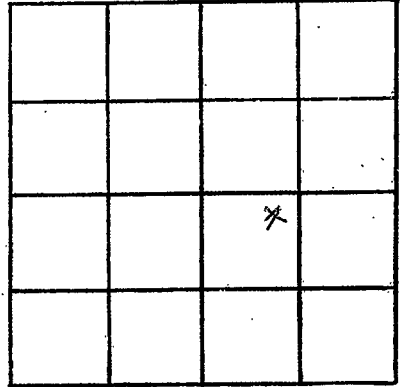

SECTION 29

Please indicate well location X.

ADDITIONAL INFORMATION

If more than one screen, show locations of each on sketch.