

TALLAHATCHIE

~~Baldwin~~

C 31

6-12-76

MISSISSIPPI
BOARD OF WATER COMMISSIONERS
416 North State Street
Jackson, Mississippi 39201

WATER WELL DRILLERS LOG

TALL.

6-12

date well completed

1976 Delta Well Supply

firm name

~~Baldwin~~

county well located


LANDOWNER:	description of formations encountered	from	to
Mary Davis	topsoil	0	21
Tutwiler Miss. (mailing address)	fine sand	21	36
	clay	36	41
	sand	41	56
	sand & pea gravel	56	100
	Bottom on clay		100
WELL LOCATION: sec. 31 T. 25 N. R. 2 E. W. 2 mi. miles South of Tutwiler (distance) (direction) (nearest town)			
WELL PURPOSE: Irrigation (home, irrigation, municipal, industrial)			
WELL COMPLETION DATA: (1) diameter (inches) 8" (2) total depth (feet) 100 (3) static water level (feet) 26 below above top of ground. (4) casing 8" steel (material) (depth) (size) if telescope see back. (5) screen 24" (length) (depth to top) 10" steel (size) (material) (6) pump (HP) (yield gpm) (type power) (7) electric log no (yes or no) (organization running log) (8) how well bottom plugged steel plate			
DRILLERS REMARKS:			

RECEIVED

JUL 19 1976

If well telescopes please sketch and show depths.

GROUND LEVEL

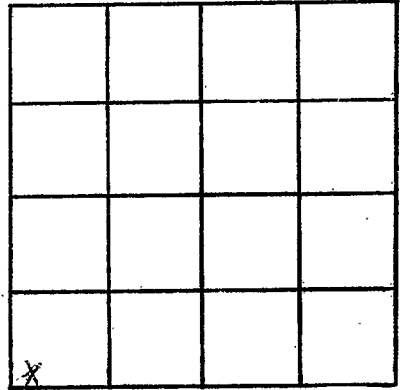

SECTION 31

Please indicate well location X.

ADDITIONAL INFORMATION

If more than one screen,
show locations of each on sketch.