

6

Tallahatchie
C-33
11-5-79

MISSISSIPPI
BOARD OF WATER COMMISSIONERS
416 North State Street
Jackson, Mississippi 39201

CODED

WATER WELL DRILLERS LOG

11-5 date well completed 1979 firm name Five Co. Farmers Assn Tallahatchie county well located

LANDOWNER: <u>Herbert Botliff</u> <u>Textville Miss</u>	description of formations encountered	from	to
(mailing address)	<u>top clay</u>	0	17
	<u>fine sand</u>	17	30
	<u>coarse sand</u>	30	44
	<u>sand & gravel</u>	44	104
WELL LOCATION: sec <u>31</u> T <u>25</u> N R <u>2</u> E S <u>5</u> W <u>1</u>			
<u>1 2</u> miles <u>south</u> of <u>Textville</u> (distance) (direction) (nearest town)			
WELL PURPOSE: (home, irrigation, municipal, industrial)			
WELL COMPLETION DATA:			
(1) diameter (inches) <u>12"</u>			
(2) total depth (feet) <u>104'</u>			
(3) static water level (feet) <u>20</u> ^{below} _{above} top of ground.			
(4) casing <u>steel</u> <u>54</u> (material) (depth)			
_____ if telescope see back. (size)			
(5) screen <u>50'</u> <u>54</u> (length) (depth to top)			
<u>12"</u> <u>steel</u> (size) (material)			
(6) pump <u>40</u> <u>1600</u> (HP) (yield gpm)			
<u>direct</u> (type power)			
(7) electric log <u>yes</u> (yes or no)			
_____ (organization running log)			
(8) how well bottom plugged <u>washed cap</u>			
DRILLERS REMARKS:			


DEPT. OF NATURAL RESOURCES
BUREAU OF LAND & WATER RESOURCES

NOV 19 1979

RECEIVED

If well telescopes please sketch and show depths.

GROUND LEVEL

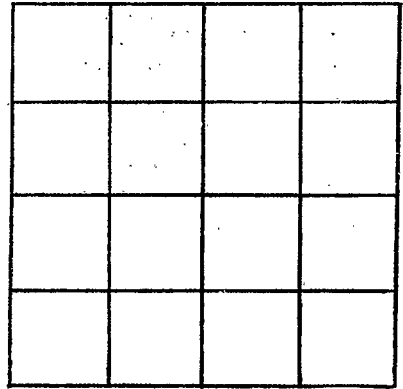

SECTION 31

Please indicate well location X.

ADDITIONAL INFORMATION

If more than one screen,
show locations of each on sketch.