

Tallahatchie
C-34
7-2-79

MISSISSIPPI
BOARD OF WATER COMMISSIONERS
416 North State Street
Jackson, Mississippi 39201

CODED

WATER WELL DRILLERS LOG

7/2 date well completed 1979 DYER WELL + IRR firm name TALLAHATCHIE county well located

LANDOWNER:	description of formations encountered	from	to
J. B. BAKER TUTWILER (mailing address)	CLAY	0	45
WELL LOCATION: sec. 28 T 25 N R 2 E S W 1 1/2 miles E of TUTWILER (distance) (direction) (nearest town)	FINE SAND	45	50
WELL PURPOSE: (home, irrigation, municipal, industrial)	SAND	50	55
WELL COMPLETION DATA: (1) diameter (inches) 12	SAND & GRAVEL	55	96
(2) total depth (feet) 96			
(3) static water level (feet) 19 below top of ground.			
(4) casing STEEL 56 (material) (depth) 12 (size) if telescope see back.			
(5) screen 40 (length) 56 (depth to top)			
(6) pump 15 (HP) STEEL (yield gpm)			
(7) electric log NO (yes or no) ELECTRIC (type power)			
(8) how well bottom plugged PLATE (organization running log)			
DRILLERS REMARKS:			


DEPT. OF NATURAL RESOURCES
BUREAU OF LAND & WATER RESOURCES

NOV 13 1979

RECEIVED

If well telescopes please sketch and show depths.

GROUND LEVEL

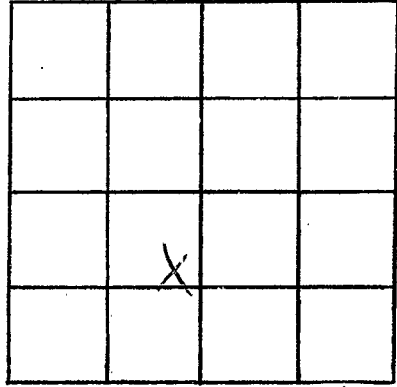

SECTION 2Y

Please indicate well location X.

ADDITIONAL INFORMATION

A series of horizontal lines for writing additional information, starting below the 'ADDITIONAL INFORMATION' header and extending to the bottom of the page.

If more than one screen, show locations of each on sketch.