

SE Brunk

Tallahatchie  
C 41  
-69  
USGS

MISSISSIPPI  
BOARD OF WATER COMMISSIONERS  
416 North State Street  
Jackson, Mississippi, 39201  
MS-GW-12717  
WATER WELL DRILLERS LOG

CODED

19 Robert E. Ratliff Co. Tallahatchie  
date well completed firm name county well located

LANDOWNER: Town of Tutwiler, Miss.  
(mailing address)  
WELL LOCATION:  
sec. 29 T 25 S R 2 E  
1N miles TOWN of \_\_\_\_\_  
(distance) (direction) (nearest town)

description of formations encountered	from	to
Gumbo	0	50
Fine Sand & Gravel	50	115
White Clay	115	139
Sand	139	315
Hard Shale	315	520
Hard Shale W/Sand Streaks	520	733
Gumbo	733	878
Sand	878	950
Good Sand	950	1020
Hard Shale	1020	1160

WELL PURPOSE:  
(home, irrigation, municipal, industrial)

WELL COMPLETION DATA:

- (1) diameter (inches) 10"
- (2) total depth (feet) 1160'
- (3) static water level (feet) \_\_\_\_\_ below/above top of ground.
- (4) casing Steel, ~~XXXX~~, 960'  
(material) (depth)  
10" if telescope see back.  
(size)
- (5) screen 40', 960'  
(length) (depth to top)  
1", Stainless Steel  
(size) (material)
- (6) pump \_\_\_\_\_ (HP) \_\_\_\_\_ (yield gpm)  
Electric  
(type power)
- (7) electric log Yes  
USGS (yes or no)  
Miss. Geological  
(organization running log)
- (8) how well bottom plugged \_\_\_\_\_


DRILLERS REMARKS:

CODED

MISSISSIPPI  
BOARD OF WATER COMMISSIONERS  
JAN 1 1968

If well telescopes please sketch and show depths.

GROUND LEVEL

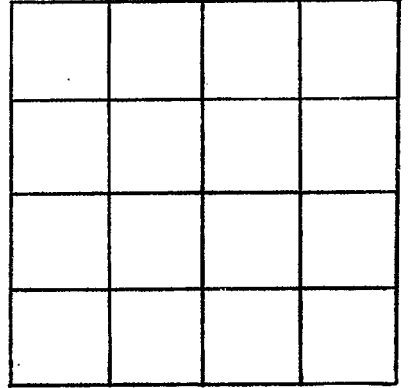

SECTION \_\_\_\_\_

Please indicate well location X.

ADDITIONAL INFORMATION

If more than one screen,  
show locations of each on sketch.