

15F

CODED

CODED

CODED

Tallahatchie
C 51
12-9-68

MISSISSIPPI
 BOARD OF WATER COMMISSIONERS
 416 North State Street
 Jackson, Mississippi 39201

WATER WELL DRILLERS LOG

12-9-68 date well completed FIVE COUNTY FARMERS ASSN firm name TALLAHATCHIE county well located

LANDOWNER: T.S. TURNER

description of formations encountered	from	to
Clay	0	25
sand - MED-	25	65
Coarse sand	65	108
Sand + gravel	108	173
Clay	173	477
Fine sand	477	496
Clay	496	498
Rock 3" or	498	498
Clay	498	517
Rock 12"	517	518
Clay	518	538
Rock 8"	538	538
Clay	538	575
Rock 6"	575	575
Clay	575	583
Clay	583	590
Rock 6"	590	590
Clay	590	595
Rock 6"	595	595
Clay	595	804
White Sand	804	824
Clay	824	867
White Sand	867	931

Turwiler Miss.
 (mailing address)

WELL LOCATION:
 sec. 15 T. 25 N. R. 2
1 1/2 miles NE of Turwiler
 (distance) (direction) (nearest town)

WELL PURPOSE: Home
 (home, irrigation, municipal, industrial)

WELL COMPLETION DATA:

- (1) diameter (inches) 2 1/2" x 4"
- (2) total depth (feet) 932
- (3) static water level (feet) 3 below above top of ground.
- (4) casing Blk Pipe - 932
 (material) (depth)
2 1/2" x 4" if telescope see back.
 (size)
- (5) screen 30' 902
 (length) (depth to top)
2 1/2" Stainless steel
 (size) (material)
- (6) pump 1 2.5
 (HP) (yield gpm)
Elec.
 (type power)
- (7) electric log NO
 (yes or no)

(organization running log)

(8) how well bottom plugged Washed


DRILLERS REMARKS:

DEC 12 1968

MISS. BD. OF WATER COMM.

If well telescopes please sketch and show depths.

GROUND LEVEL

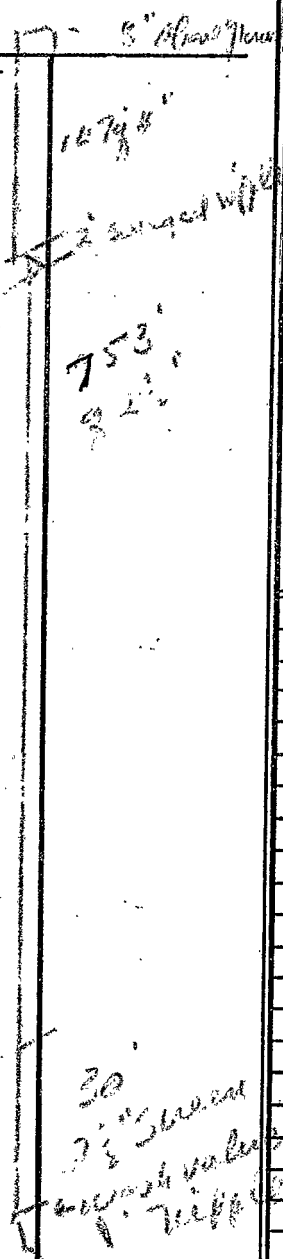

SECTION 15

Please indicate well location X.

ADDITIONAL INFORMATION

1 HP. Submersible pump

If more than one screen, show locations of each on sketch.