

MISSISSIPPI DEPARTMENT OF NATURAL RESOURCES

Bureau of Land and Water Resources

Southport Mall

P.O. Box 10631

Jackson, Mississippi 39209

WATER WELL DRILLERS LOG

Tallahatchie  
 C 55  
 Gw 745

CODED

3-13 19 85 Dyer Well Inc Tallahatchie  
 date well completed firm name county well located

LANDOWNER: William Falls  
 Box 552  
 Weller, Ms. 38966  
 (mailing address)

description of formations encountered	from	to
Clay	0	35
Sand	35	38
Sand + Gravel	38	92

WELL LOCATION:  
 sec. 15 T 25 N R 2 E  
 3 miles E of Tutwiler  
 (distance) (direction) (nearest town)

WELL PURPOSE: Irrigation  
 (home, irrigation, municipal, industrial)


WELL COMPLETION DATA:  
 (1) diameter (inches) 16"  
 (2) total depth (feet) 92  
 (3) static water level (feet) \_\_\_\_\_ below above top of ground.  
 (4) casing Steel, 52'  
 (material) (depth)  
 \_\_\_\_\_ If telescope see back.  
 (size)  
 (5) screen 40', 52'  
 (length) (depth to top)  
 16, Steel  
 (size) (material)  
 (6) pump 60, 1200  
 (HP) (yield gpm)  
 Diesel  
 (type power)  
 (7) electric log No  
 (yes or no)  
 \_\_\_\_\_  
 (organization running log)  
 (8) how well bottom plugged Steel Plate

CODED

DRILLERS REMARKS:

If well telescopes please sketch and show depths.

GROUND LEVEL

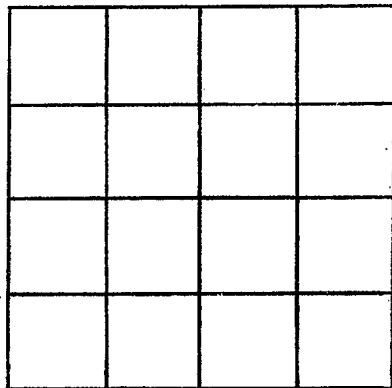

SECTION \_\_\_\_\_

Please indicate well location X.

ADDITIONAL INFORMATION

If more than one screen, show locations of each on sketch.