

MISSISSIPPI DEPARTMENT OF NATURAL RESOURCES

CODED

Bureau of Land and Water Resources

Southport Mall

P.O. Box 10631

Jackson, Mississippi 39209

WATER WELL DRILLERS LOG

ALLA HATCHIE  
C 56

3-12 1985 Dyer Well, Inc Jallopatchie  
date well completed firm name county well located

LANDOWNER: William Falls  
P.O. Box 552  
Webb, Mo. 38966  
(mailing address)

description of formations encountered	from	to
	Clay	0
fine sand	28	36
sand & gravel	36	91

WELL LOCATION:  
sec. 10 T. 25 N. R. 2 E.  
S. (W)  
2 miles E. of Sutwiler  
(distance) (direction) (nearest town)

WELL PURPOSE: drinking  
(home, irrigation, municipal, industrial)

WELL COMPLETION DATA:

(1) diameter (inches) 16"

(2) total depth (feet) 91'

(3) static water level (feet) \_\_\_\_\_ below above top of ground.

(4) casing Steel, 51',  
(material) (depth)  
\_\_\_\_\_ If telescope see back.  
(size)

(5) screen 40', 51'  
(length) (depth to top)  
16, Steel  
(size) (material)

(6) pump 100 1350  
(HP) (yield gpm)  
Diesel  
(type power)

(7) electric log NO  
(yes or no)  
\_\_\_\_\_  
(organization running log)


(8) how well bottom plugged Steel Plate

CODED

DRILLERS REMARKS: \_\_\_\_\_

If well telescopes please sketch and show depths.

GROUND LEVEL

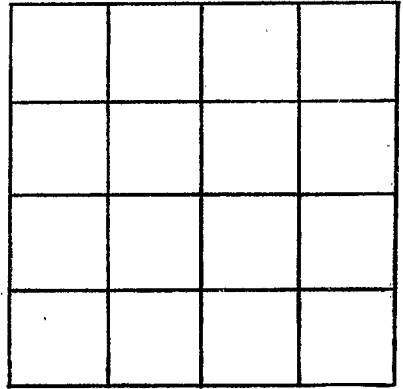

SECTION \_\_\_\_\_

Please indicate well location X.

ADDITIONAL INFORMATION

A series of horizontal lines providing space for additional information.

If more than one screen, show locations of each on sketch.