

MISSISSIPPI DEPARTMENT OF NATURAL RESOURCES

Bureau of Land and Water Resources

Southport Mall

P.O. Box 10631

Jackson, Mississippi 39209

WATER WELL DRILLERS LOG

Tallahatchie
C 57

CODED

3-11 1985 Dyer Well Inc Tallahatchie
date well completed firm name county well located


LANDOWNER:	description of formations encountered	from	to
<u>William Falls</u> <u>Box 552</u>			
<u>Webb, Mrs. 38966</u> (mailing address)	<u>Clay</u>	<u>0</u>	<u>26</u>
	<u>fine sand</u>	<u>26</u>	<u>65</u>
	<u>sand</u>	<u>65</u>	<u>75</u>
	<u>sand & gravel</u>	<u>75</u>	<u>95</u>
WELL LOCATION: sec. <u>9</u> T <u>25</u> N R <u>2</u> E S W			
<u>2</u> miles <u>E</u> of <u>Intwiler</u> (distance) (direction) (nearest town)			
WELL PURPOSE: <u>drinking</u> (home, irrigation, municipal, industrial)			
WELL COMPLETION DATA:			
(1) diameter (inches) <u>16"</u>			
(2) total depth (feet) <u>95'</u>			
(3) static water level (feet) _____ below above top of ground.			
(4) casing <u>steel</u> , <u>55'</u> (material) (depth)			
_____ if telescope see back. (size)			
(5) screen <u>40'</u> , <u>55'</u> (length) (depth to top)			
<u>16"</u> , <u>steel</u> (size) (material)			
(6) pump <u>60</u> , <u>1150</u> (HP) (yield gpm)			
<u>Diesel</u> (type power)			
(7) electric log <u>No</u> (yes or no)			
_____ (organization running log)			
(8) how well bottom plugged <u>Steel Plate</u>			

CODED

DRILLERS REMARKS:

If well telescopes please sketch and show depths.

GROUND LEVEL

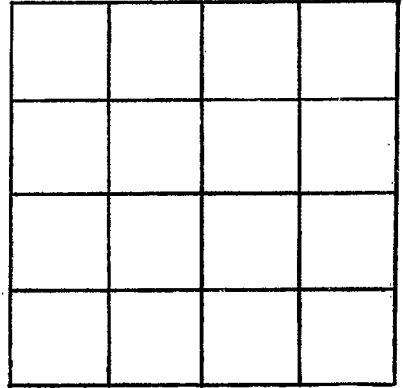

SECTION _____

Please indicate well location X.

ADDITIONAL INFORMATION

A series of 20 horizontal lines provided for entering additional information.

If more than one screen, show locations of each on sketch.