County:	Tallahatchie		
Pormit #	3W L	10216	
Irrig Driller: _	ation	Equipment	
Date drillis	ng completed:	5-5-05	

State Well Report

Part 1

Mississippi Department of Environmental Quality
Office of Land and Water Resources
P.O. Box 10631
Jackson, MS 39289-0631
(601)961-5210
(601)354-6938 (fax)

For Office Use Only:	
Aquifer:	
Well #:	
L. S. Elevation:	
E-log #:	_

State Law requires that this report be prepared by the driller in detail and filed with the Department within


30 days of completion of drilling of the well.	
Well Owner Information Swindoll Farms Partnership	Well Location 33 59 41 7 90 23 20 1
Owner Name	33 59 41.7 90 23 20.1 Latitude: Longitude: Tongitude: Ton
Mailing Address: 5253 Willis Road	Method of Lat/Long (circle one): Conventional Survey,
	USGS quad, Hand-held GPS, Survey-grade GPS
Tutwiler, MS 38963	SW 1/4 SE 1/4 Sec 28 Twn 25N Rng 2W
City State Zip Code	Distance Direction Nearest Town
662-627-5591 Telephone No. ()	Distance Direction Nearest Town 2 Miles SE of Tutwiler
Well	Data
Purpose of Well (circle one) Home Industrial Public Supply	Arrigation Fish Culture Other:
Date well drilling started: $5-5-05$ Date v	
If flowing, method of flow regulation: Valve Other (d	lescribe)
Static Water Level: 25 feet above or felow (circle one)	
Method of Measurement (circle one) steel tape electric tape	air line other:
Hole depth: 117' Well depth: 117'	Well grouted to a depth of 10 feet
Type of grout (circle one): Cement Bentonite Mix	
Casing length: 77 feet Casing diameter: 10	inches Type of casing:PVC 160
Screen length: 40 feet Screen diameter: 10	inches Type of screen: <u>DVC 160</u>
Screen slot size: inches Setting depth: From _	78feet to117feet
Type of completion (circle all applicable): Oravel packed Under	rreamed Telescoped Open hole Natural Development
Other (describe):	
Top of lap pipe or reduction in casing:feet. If te	descoped or more than one screen, describe on back of page
Logs run (circle all applicable). No log run Electric Gamma Ray	Density Sonic Neutron Other:
Name of organization running log(s):	1 (d. H N 1)
I certify that the well was drilled, constructed, and completed in	
Department of Environmental Quality and/or the Mississippi De Irrigation Equipment Inc.	has emerse or recent references were sens sens
Patrick M. Chism 0695	tatrick M Chin
Print Name of Water Well Contractor and License No.	Signature of Water Well Contractor

Ground Level

Description of Formations Encountered	From	То
Clay Fine Sand	0	25
	26	45
Med. Sand	46	5.5
Coarse Sand/gravel.	56	117
,		\square
	L	
		\sqcup
	<u> </u>	
	<u> </u>	
		igsquare
	<u> </u>	
	Ī	$oldsymbol{ol}}}}}}}}}}}}}}}}}}$

If more than one screen, show location of each on sketch

Sketch the property layout and include the following: 1) the well location; 2) any permanent structures on the property that may aid in locating the well; 3) any roads, power lines, or other items that may aid in locating the property and the well; 4) indicate direction.

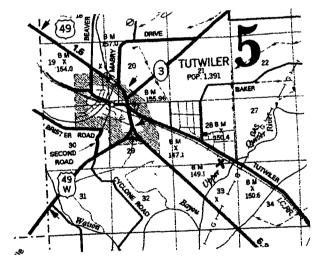

Landowner Name:	
-----------------	--

Signature of Water Well Contractor

STATE WELL REPORT

Tallahatchie County: Permit #: GW Irrigation Equipment 5-6-05

Date completed: ___

Part 2 Pump Installer's Completion Report

Mississippi Department of Environmental Quality Office of Land and Water Resources P.O. Box 10631 Jackson, MS 39289-0631 (601)961-5210 (601)354-6938 (fax)

For Office Use Only:		
Aquifer:		
Well #:	C-75	_
Elevation	n:	_

Swindoll Farms Partnership	Well Location
DWINGS PARTHUOLI FARMS PARTHERSNIP	Latitude: Longitude:
Mailing Address: 5253 Willis Road	Method of Lat/Long (circle one): Conventional Survey,
Tutwiler, MS 38963 City State Zip Code 662-627-5591 Telephone No. ()	USGS quad, Hand-held GPS, Survey-grade GPS SW SE
Pump Type Circle one	Power Type Circle one
Air Lift Jet Submersible	Diesel Engine Gasoline Engine Natural Gas
Bucket Piston Turbine	Electric Motor Hand Tractor PTO
Centrifugal Rotary Flowing Well	Windmill Other (specify):
Other (specify):	Horse Power Rating of Motor: 25
Date Pump Installed: 5-6-05	Setting Depth: 70 feet
1100-1200 Rated Pump Capacity: 1200 Gallons Per Minute	Number of Stages:1
Pump Test Data	Method of Measuring Water Level Circle one
Date Well Tested: Static Water Level (A): Feet Below Land Surface Pumping Water Level (B): Feet Below Land Surface	Air Line Electric Measuring Line Steel Tape Other (specify):
Drawdown [(B) – (A)]:Feet Below Land Surface	For flowing well, measured shut in head:feet
Test Pumping Rate:Gallons Per Minute	Well yieldedGPM with a drawdown of
	feet afterhours of pumping

