County:	. Tallahatchie		
Pennit #: Irri Driller:		Equipment	
•	ling completed:	3-8-06	

State Well Report

Part 1

Mississippi Department of Environmental Quality
Office of Land and Water Resources
P.O. Box 10631
Jackson, MS 39289-0631
(601)961-5210
(601)354-6938 (fax)

For Office Use Only:	
Aquifer:	
Well #:	C-84
L. S. Elev	vation:
E-log #:	

State Law requires that this report be prepared by the driller in detail and filed with the Department within

30 days of completion of drilling of the well.				
Well Owner Information	Well Location			
Owner Name Farmers National Company	Latitude: 33 .59 20.1 N Longitude: 26 4.9.9 W			
285 German Oak Drive, Suite 3 Mailing Address:	Method of Lat/Long (circle one): Conventional Survey,			
	USGS quad, Hand-held GPS, Survey-grade GPS			
	SW SW Sw 14 Sec 31 V Twn 25N Rng 2W			
Cordova TN 38018				
City State Zip Code	Distance Direction Nearest Town 2 Miles SW of Tutwiler			
Telephone No. (901-755-0350	Watson Bayou			
Well I				
	Irrigation Fish Culture Other:			
Date well drilling started: 3-8-06 Date w	well drilling completed: 3-8-06			
If flowing, method of flow regulation: Valve Other (d	escribe)			
Static Water Level:feet above of below (circle one) l	and surface Date measured: 3-8-06			
Method of Measurement (circle one) (steel tape electric tape	air line other:			
Hole depth: 125 Well depth: 125	Well grouted to a depth of 10 feet			
Type of grout (circle one): Cement Bentonite Mix				
Casing length: 85 feet Casing diameter: 12	inches			
Screen length: 40 feet Screen diameter: 12	inches Type of screen:PVC			
Screen slot size: . 050 inches Setting depth: From	86feet_to125feet			
Type of completion (circle all applicable): Gravel packed Underreamed Telescoped Open hole Natural Development				
Other (describe):				
Top of lap pipe or reduction in casing:feet. If telescoped or more than one screen, describe on back of page				
Logs run (circle all applicable) No log run Electric Gamma Ray Density Sonic Neutron Other:				
Name of organization running log(s):				
I certify that the well was drilled, constructed, and completed in accordance with all applicable requirements of the Mississippi				
Department of Environmental Quality and/or the Mississippi Department of Health regulations and state laws.				
Irrigation Equipment Inc. Patrick M. Chism 0695	Patro M Chi			
Print Name of Water Well Contractor and License No.	Signature of Water Well Contractor			

RECEIVED


MAR 2 0 2006

BY: OLWR

Ground Level

Description of Formations Encountered	From	То
Clav	0	29
Fine Sand Fine Sand/gravel	30	45
Fine Sand/gravel	46	54
Med. Sand	55	59
Med. Sand/gravel	60	125
	-	
		
		
		-
		
		-
		1
	L	<u> </u>

If more than one screen, show location of each on sketch

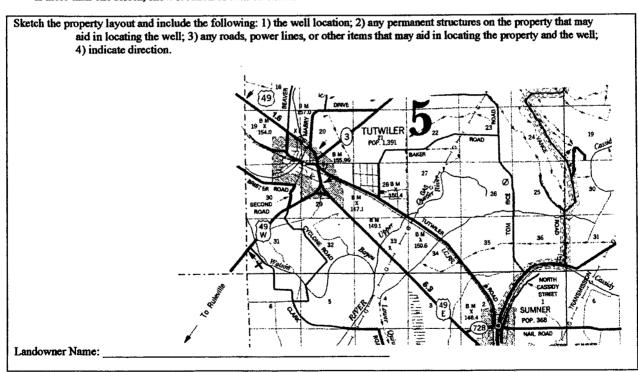

Signature of Water Well Contractor

STATE WELL REPORT

County: Tallahatchie Permit#: Irrigation Equipment Dailer: Date completed: 3-8-06

Part 2
Pump Installer's Completion Report
Mississippi Department of Environmental Quality
Office of Land and Water Resources
P.O. Box 10631
Jackson, MS 39289-0631
(601)961-5210

For Office Use Only:		
Aquifer:		
weil#: <u>C -</u> 84		
Elevation:		

(601)35	4-0938 (Iax)			
This report should be prepared by the pump installer in deta installation of pump.				
Well Owner Information	Well Location			
Owner Name: Farmers National Company	Latitude:Longitude:			
285 German Oak Drive, Suite 3	Method of Lat/Long (circle one): Conventional Survey,			
	USGS quad, Hand-held GPS, Survey-grade GPS			
Cordova TN 38018 City State Zip Code	¼¼ Sec31 _Twn_25N_Rng_2W			
City Suite 22p Code	Distance Direction Nearest Town			
Telephone No. ()	2 Miles SW of Tutwiler			
Pump Type Circle one	Power Type Circle one			
Air Lift Jet Submersible	Diesel Engine Gasoline Engine Natural Gas			
Bucket Piston Turbine	Electric Motor Hand Tractor PTO			
Centrifugal Rotary Flowing Well	Windmill Other (specify):			
Other (specify):	Horse Power Rating of Motor: 40			
Date Pump Installed: 3-8-06	Setting Depth: 80 feet			
Rated Pump Capacity: 1600 Gallons Per Minute	Number of Stages:1			
Pump Test Data	Method of Measuring Water Level			
Date Well Tested:	Circle one			
Static Water Level (A):Feet Below Land Surface	Air Line Electric Measuring Line Steel Tape			
Pumping Water Level (B):Feet Below Land Surface	Other (specify):			
Drawdown [(B) - (A)]:Feet Below Land Surface	For flowing well, measured shut in head:feet			
Test Pumping Rate:Gallons Per Minute	Well yieldedGPM with a drawdown of			
Duration of Pump Test (minimum 4 hours):hours	feet afterhours of pumping			
I HEREBY CERTIFY that the above statements are true to the best of my knowledge. Patrick M. Chism 0695				
Print Name of Pump Installer and License No. (if applicable) Signature of Pump Installer				

RECEIVED

MAR 2 0 2006

BY: OLWR