County: Tallaha	tchie
Permit #6W4/ Irrigation I	007 Equipment
Driller:	4-18-06

State Well Report

Part 1

Mississippi Department of Environmental Quality
Office of Land and Water Resources
P.O. Box 10631
Jackson, MS 39289-0631
(601)961-5210
(601)354-6938 (fax)

For Office Use Only:	
Aquifer:	
Well #: <u>C - 85</u>	<u>-</u>
L. S. Elevation:	
E-log #:	

State Law requires that this report be prepared by the driller in detail and filed with the Department within 30 days of completion of drilling of the well.

30 days of completion of drining of the well.		
Well Owner Information	Well Location	
Owner Name Swindoll Farm Partnership	Latitude: 33 .59 27.7, Longitude: 90 .24 .17.9	
Mailing Address: 5253 Willis Road	Method of Lat/Long (circle one): Conventional Survey,	
	USGS quad, Hand-held GPS, Survey-grade GPS	
	NW 1/4 SE 1/4 Sec 33 Twn 25N Rng 2W	
Tutwiler MS 38963 City State Zip Code	Distance Direction Nearest Town	
	2 Miles SE of Tutwiler	
Telephone No. 662,627-5591		
Well	Data	
Purpose of Well (circle one) Home Industrial Public Supply	(Irrigation) Fish Culture Other:	
Date well drilling started: 4-18-06 Date v	well drilling completed: 4-18-06	
If flowing, method of flow regulation: Valve Other (d		
Static Water Level: 29' feet above or below (circle one)	land surface Date measured: $4-19-06$	
	air line other:	
Hole depth: 120 Well depth: 120 Well grouted to a depth of 10 feet		
Type of grout (circle one): Cement Bentonite Mix		
Casing length: 80 feet Casing diameter: 16 inches Type of casing: PVC Sch. 40		
Screen length: 40 feet Screen diameter: 16	inches Type of screen: PVC Sch. 40	
Screen slot size: 050 inches Setting depth: From _	81feet to120feet	
Type of completion (circle all applicable): Gravel packed Under	rreamed Telescoped Open hole Natural Development	
Other (describe):		
Top of lap pipe or reduction in casing: feet. If to	elescoped or more than one screen, describe on back of page	
Logs run (circle all applicable) No log run Electric Gamma Ray Density Sonic Neutron Other:		
Name of organization running log(s):		
I certify that the well was drilled, constructed, and completed in accordance with all applicable requirements of the Mississippi		
Department of Environmental Quality and/or the Mississippi Department of Health regulations and state laws.		
Irrigation Equipment Inc. Patrick M. Chism 0695	Patr M Ch	
Print Name of Water Well Contractor and License No.	Signature of Water Well Contractor	

RECEIVED


APR 2 8 2006

BY: OLWR

Ground Level

Description of Formations Encountered	From	To
Clay	0	32
Fine Sand	3.3	44
Fine Sand/gravel Med. Sand/gravel	4.5	50
Med. Sand/gravel	51	129
	 	
		\vdash
	-	-
		-
	+	-1
	+	+-1
	 	$\vdash \vdash \vdash$
	 	+-
	+	
		
	1	
		1
		$\dagger \Box \dagger$
	7	
	1	\top
		T

If more than one screen, show location of each on sketch

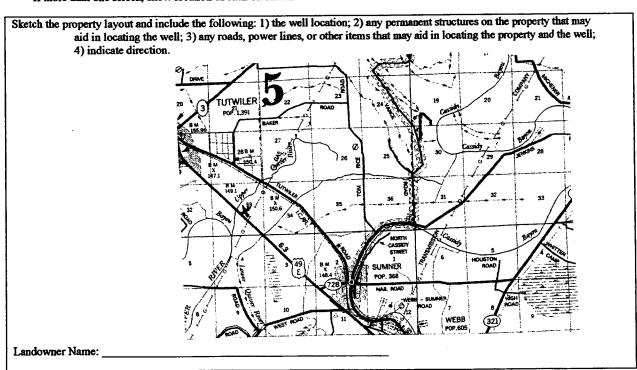

Signature of Water Well Contractor

STATE WELL REPORT

Part 2

Tallahatchie **Pump Installer's Completion Report** Permit #: 6w 41007 Mississippi Department of Environmental Quality Irrigation Equipment Office of Land and Water Resources P.O. Box 10631 4-18-06 Jackson, MS 39289-0631 Date completed: (601)961-5210

For Office Use Only:	
Aquifer:	
Well #:	C.85
Elevation:	

Copy information from block on Part 1	(601)35	4-6938 (fax)	Elevation:
This part of the report must be completed by a licensed water well contractor or a licensed pump installer. A copy of Part 1 of the report must be attached and both parts filed with the Department at the above address within 30 days of well completion.			
Well Owner Informa Swindoll Farm 1	tion	Wel	l Location
Owner Name: 5253 Willis Mailing Address:	Road		Longitude:
			GPS, Survey-grade GPS
Tutwiler MS		NW 1/4 SE 1/4 Sec 33	
	Zip Code	Distance Direction	Nearest Town
662-627-559° Telephone No. ()		O Miles _SEo	f_Tutwiler
Pump Type Circle one			wer Type ircle one
Air Lift Jet	Submersible	Diesel Engine Gasolin	e Engine Natural Gas
Bucket Piston	Turbine	Electric Motor Hand	Tractor PTO
Centrifugal Rotary	Flowing Well		specify):
Other (specify):		Horse Power Rating of Motor:	60
Date Pump Installed: $4-19-06$	5	Setting Depth: 70	feet
Rated Pump Capacity: 2500-3000	Gallons Per Minute	Number of Stages: 1	
Pump Test Data			asuring Water Level rcle one
Date Well Tested:		Air Line Electric Mea	suring Line Steel Tape
Static Water Level (A): Feet Pumping Water Level (B): Feet		Other (specify):	
Drawdown [(B) – (A)]:Feet	Below Land Surface	For flowing well, measured sh	ut in head:feet
Test Pumping Rate:	Gallons Per Minute	Well yielded	_GPM with a drawdown of
Duration of Pump Test (minimum 4 hours):	hours	feet after	hours of pumping
I HEREBY CERTIFY that the above statements are true to the best of my knowledge. Patrick M. Chism 0695 Print Name of Pump Installer and License No. (if applicable) Signature of Pump Installer			

Form: OLWR-SWR-1B

RECEIVED

APR 2 8 2006

BY: OLWR

، 	Sta
County: Tallahatchie	
	Mississippi Depa
Permit #:	Office of
Irrigation Equipment	
	Jack
Date drilling completed: 4-18-06	
	(6

te Well Report

Part 1

artment of Environmental Quality Land and Water Resources P.O. Box 10631 son, MS 39289-0631 (601)961-5210 601)354-6938 (fax)

For Office Use Only:
Aquifer:
Well #:
L. S. Elevation:
E-log #:

State Law requires that this report be prepared by the driller in detail and filed with the Department within

30 days of completion of drilling of the well.	-	
Well Owner Information	Well Location	
Owner Name Swindoll Farm Partnership	Latitude: 33 .59 27.7, Longitude: 90 .24 .17.9	
Mailing Address: 5253 Willis Road	Method of Lat/Long (circle one): Conventional Survey,	
	USGS quad, Hand-held GPS, Survey-grade GPS	
	NW 1/4 SE 1/4 Sec 33 Twn 25N Rng 2W	
Tutwiler MS 38963		
City State Zip Code	Distance Direction Nares Toys V	
Telephone No. (662, 627-5591	2 Miles SF of Tatwiler	
	MAY - 4 2006	
Well I	Data 17/A) 5 4 2000	
Purpose of Well (circle one) Home Industrial Public Supply		
Date well drilling started: 4-18-06 Date v	vell drilling completed: 4 M/SNAGEMENT DISTRICT	
If flowing, method of flow regulation: Valve Other (de	escribe)	
Static Water Level: 29' feet above or below (circle one) I	<u> </u>	
Static Water Level: 29 feet above or below (circle one) l	and surface Date measured:	
	air line other:	
Hole depth: 120 Well depth: 120	Well grouted to a depth of feet	
Type of grout (circle one): Cement Bentonite Mix		
Casing length: 80 feet Casing diameter: 16	inches Type of casing: PVC Sch. 40	
Screen length: 40 feet Screen diameter. 16		
Screen slot size:050 inches Setting depth: From	81 feet to 120 feet	
Type of completion (circle all applicable): Gravel packed Under	reamed Telescoped Open hole Natural Development	
Other (describe):		
Top of lap pipe or reduction in casing: feet. If tel	escoped or more than one screen, describe on back of page	
Logs run (circle all applicable) No log run Electric Gamma Ray	Density Sonic Neutron Other:	
Name of organization running log(s):	,.	
I certify that the well was drilled, constructed, and completed in accordance with all applicable requirements of the Mississippi		
Department of Environmental Quality and/or the Mississippi Department of Health regulations and state laws.		
Irrigation Equipment Inc. Patrick M. Chism 0695	Pt/Mch	
Print Name of Water Well Contractor and License No.	Signature of Water Well Contractor	