

Tallahatchie  
 C 2001

MISSISSIPPI DEPARTMENT OF NATURAL RESOURCES  
 Bureau of Land and Water Resources  
 Southport Mall  
 P.O. Box 10631  
 Jackson, Mississippi 39209  
**WATER WELL DRILLERS LOG**

5-27 1982 Moore's Well Drilling, Inc. Tallahatchie  
 date well completed firm name county well located

LANDOWNER: Morgan A. Lopez  
Pl. 1  
Drew Miss.  
 (mailing address) 38799

description of formations encountered	from	to
<u>Topsoil &amp; clay</u>	<u>1'</u>	<u>28'</u>
<u>1' Sand - Small Grain</u>	<u>28'</u>	<u>39'</u>
<u>Larger Grain Sand</u>	<u>39'</u>	<u>70'</u>
<u>Small Grain Sand</u>	<u>70'</u>	<u>79'</u>
<u>Larger Grain Sand</u>	<u>79'</u>	<u>85'</u>
<u>Larger Grain Sand, Small Grain</u>	<u>85'</u>	<u>90'</u>

WELL LOCATION:  
 sec. 15 T 25 N R 2 E  
8 miles N of Well Miss.  
 (distance) (direction) (nearest town)

WELL PURPOSE: Home  
 (home, irrigation, municipal, industrial)

- WELL COMPLETION DATA:
- (1) diameter (inches) 2"
  - (2) total depth (feet) 90'
  - (3) static water level (feet) 28 below top of ground
  - (4) casing PVC (material), (depth)  
 (size) If telescope see back.
  - (5) screen 10' (length), (depth to top)  
2" (size), PVC (material)
  - (6) pump 1/2 (HP), 9 (yield gpm)  
Electric (type power)
  - (7) electric log (yes or no)  
 (organization running log)
  - (8) how well bottom plugged PVC Cap

DRILLERS REMARKS:


DEPT. OF NATURAL RESOURCES  
 BUREAU OF LAND & WATER RESOURCES

JUL 12 1982

RECEIVED

If well telescopes please sketch and show depths.

GROUND LEVEL

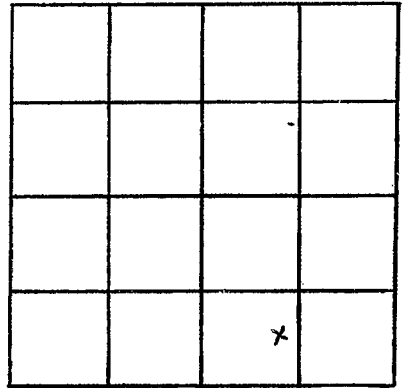

SECTION 15

Please indicate well location X.

ADDITIONAL INFORMATION

If more than one screen,  
show locations of each on sketch.