

MISSISSIPPI DEPARTMENT OF NATURAL RESOURCES

Bureau of Land and Water Resources

Southport Mall

P.O. Box 10631

Jackson, Mississippi 39209

WATER WELL DRILLERS LOG

Tallahatchie
C 2002

6 1987 St. Powell & Co., Inc. Tallahatchie
date well completed firm name county well located

LANDOWNER: E.M. Fedric
1435 Shelby Drive
Clarksdale MS
(mailing address) 38618

description of formations encountered	from	to
<u>Clay</u>	<u>0</u>	<u>13</u>
<u>Fine Sand</u>	<u>13</u>	<u>53</u>
<u>Coarse Sand</u>	<u>53</u>	<u>110</u>

WELL LOCATION:
sec. 7 T 25 N R 2 E
7 miles SW of Dublin
(distance) (direction) (nearest town)

WELL PURPOSE: ERR
(home, irrigation, municipal, industrial)

- WELL COMPLETION DATA:
- (1) diameter (inches) 16
 - (2) total depth (feet) 110
 - (3) static water level (feet) 20 below above top of ground.
 - (4) casing Steel, 70,
(material) (depth)
(size) if telescope see back.
 - (5) screen 40, 70
(length) (depth to top)
16, Steel
(size) (material)
 - (6) pump 60, 3000
(HP) (yield gpm)
Diesel
(type power)
 - (7) electric log _____
(yes or no)
(organization running log)
 - (8) how well bottom plugged Steel
PLATE

RECEIVED


JUL 27 1987

Department of Natural Resources
Bureau of Land & Water Resources

DRILLERS REMARKS:

If well telescopes please sketch and show depths.

GROUND LEVEL

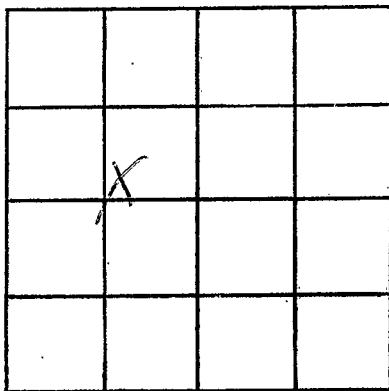

SECTION 7

Please indicate well location X.

ADDITIONAL INFORMATION

If more than one screen, show locations of each on sketch.