

MISSISSIPPI DEPARTMENT OF NATURAL RESOURCES

Bureau of Land and Water Resources

Southport Mall

P.O. Box 10631

Jackson, Mississippi 39209

WATER WELL DRILLERS LOG

Tap #  
 11740-ESD-4-9-87  
 TALLAHATCHIE  
 C-2003

88c

3-18 1989 date well completed  
 Dyer Well firm name  
 Tallahatchie county well located


LANDOWNER: F+G Farms  
 Box 552  
 Webb Ms. 38966  
 (mailing address)

description of formations encountered	from	to
CLAY	0	35
Fine Sand	35	50
Fine Sand + Gravel	50	60
M Sand + Gravel	60	70
F Sand + Gravel	70	80
M Sand + Gravel	80	105
F sand + Gravel	105	117

WELL LOCATION:  
 sec. 18 T 25 N S R 2 E W  
 miles of (distance) (direction) of (nearest town)

WELL PURPOSE: Irrigation  
 (home, irrigation, municipal, industrial)

- WELL COMPLETION DATA:
- (1) diameter (inches) 12"
  - (2) total depth (feet) 117'
  - (3) static water level (feet) \_\_\_\_\_ below above top of ground.
  - (4) casing steel (material) \_\_\_\_\_ (depth) \_\_\_\_\_  
 12" (size) if telescope see back.
  - (5) screen 40' (length) \_\_\_\_\_ (depth to top) \_\_\_\_\_  
 12" (size) \_\_\_\_\_ (material)
  - (6) pump 850 (HP) \_\_\_\_\_ (yield gpm)  
 Engine (type power)
  - (7) electric log No (yes or no)  
 None (organization running log)
  - (8) how well bottom plugged Plate

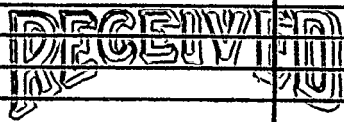


MAR 21 1989

Department of Natural Resources  
 Bureau of Land & Water Resources

DRILLERS REMARKS:

If well telescopes please sketch and show depths.

GROUND LEVEL

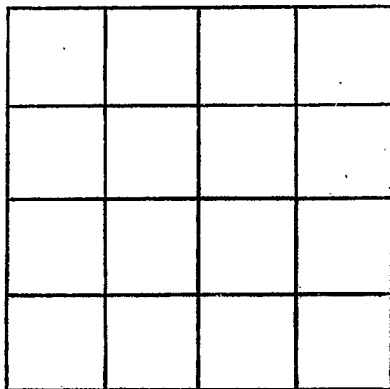

SECTION \_\_\_\_\_

Please indicate well location X.

ADDITIONAL INFORMATION

If more than one screen, show locations of each on sketch.